

MARION
N-53
8-1-71

MISSISSIPPI
BOARD OF WATER COMMISSIONERS
416 North State Street
Jackson, Mississippi 39201

CODED


WATER WELL DRILLERS LOG

8-1-71 date well completed
Hessman Well Service firm name
Marion county well located

LANDOWNER:	description of formations encountered	from	to
Jim Dunaway (mailing address)	top soil	0	1
WELL LOCATION: sec. 25 T 2 N S R 13 E W	sand + gravel	1	80
miles of (distance) (direction) (nearest town)	Chalk	80	100
WELL PURPOSE: <u>House Use</u> (home, irrigation, municipal, industrial)	fine sand	100	210
WELL COMPLETION DATA:	water sand	230	250
(1) diameter (inches) <u>4"</u>	CODED		
(2) total depth (feet) <u>250'</u>			
(3) static water level (feet) <u>195</u> below top of ground.			
(4) casing <u>Plastic, 240'</u> (material) (depth)			
_____ if telescope see back. (size)			
(5) screen <u>10'</u> , <u>240'</u> (length) (depth to top)			
<u>4</u> , <u>Plastic</u> (size) (material)			
(6) pump <u>1</u> (HP) (yield gpm)			
_____ (type power)			
(7) electric log _____ (yes or no)			
_____ (organization running log)			
(8) how well bottom plugged _____			
DRILLERS REMARKS:	AUG 2 - 1971 MISS. BD. OF WATER COMM.		

If well telescopes please sketch and show depths.

GROUND LEVEL

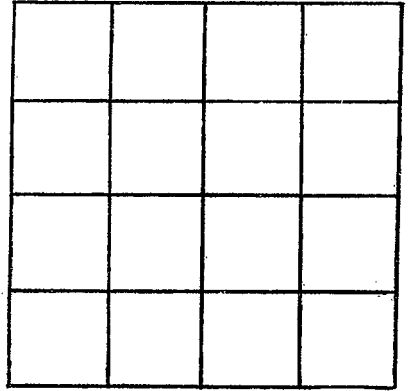

SECTION _____

Please indicate well location X.

ADDITIONAL INFORMATION

If more than one screen,
show locations of each on sketch.