

MISSISSIPPI
BOARD OF WATER COMMISSIONERS
416 North State Street
Jackson, Mississippi 39201

WATER WELL DRILLERS LOG

CODED

Marion
N-54
6-71

JUNE
date well completed

19 71 E. B. SHERRARD
firm name

MARION
county well located

LANDOWNER:

J. W. ERVIN

Rt. 2 FOXWORTH
(mailing address)

description of formations
encountered

GRAVEL CLAY
WITH SAND
SOLID PEA GRAVEL

from to

0 80'
80' 122'

WELL LOCATION:

sec. 13 T 20 N R 13 E
S W
8 miles S of Columbia
(distance) (direction) (nearest town)

WELL PURPOSE:

(home) irrigation, municipal, industrial)

WELL COMPLETION DATA:

- (1) diameter (inches) 3"
- (2) total depth (feet) 122
- (3) static water level (feet) 80 below
top of ground.
- (4) casing PL. 116'
(material) (depth)
3" if telescope see back:
(size)
- (5) screen 60'
(size) (depth to top)
(material)
- (6) pump 1/2 10
(HP) (yield gpm)
E
(type power)
- (7) electric log (yes or no)
- (organization running log)
- (8) how well bottom plugged BWV

CODED


SEP 15 1971

DRILLERS REMARKS:

MISS. BD. OF
WATER COM.

If well telescopes please sketch and show depths.

GROUND LEVEL

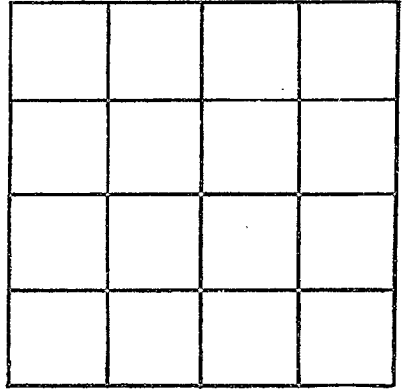

SECTION _____

Please indicate well location X.

ADDITIONAL INFORMATION

If more than one screen, show locations of each on sketch.