

MARION  
N 55  
3-5-71

MISSISSIPPI  
BOARD OF WATER COMMISSIONERS  
416 North State Street  
Jackson, Mississippi 39201

WATER WELL DRILLERS LOG

3-5-71 date well completed  
Dean Driscoll Well Service firm name  
Marion county well located

LANDOWNER:  
W. F. Dykes  
Route (mailing address)

WELL LOCATION:  
sec. 3 T. 2 N. R. 12 E  
10 miles S.W. of Columbia  
(distance) (direction) (nearest town)

WELL PURPOSE: Home Use  
(home, irrigation, municipal, industrial)


- WELL COMPLETION DATA:
- (1) diameter (inches) 2"
  - (2) total depth (feet) 122
  - (3) static water level (feet) 84 below top of ground.
  - (4) casing Plastic, 112 (material) (depth)  
(size) If telescope see back.
  - (5) screen 10' 110" (length) (depth to top)  
2" Plastic (size) (material)
  - (6) pump 1 (HP) (yield gpm)  
(type power)
  - (7) electric log (yes or no)  
(organization running log)
  - (8) how well bottom plugged

description of formations encountered	from	to
top soil	0	1
Clay	1	50
Chalk	50	72
Sand	72	122
<b>CODED</b>		
OCT 21 1971		
DRILLERS REMARKS:		

MISS. Bd. of  
WATER COMM.

If well telescopes please sketch and show depths.

GROUND LEVEL

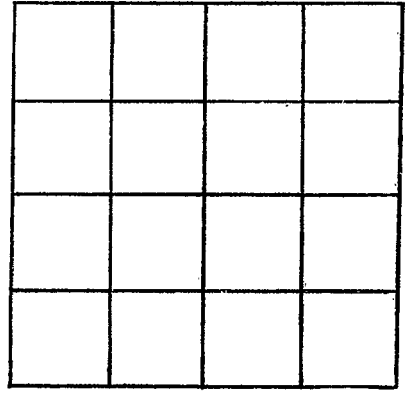

SECTION \_\_\_\_\_

Please indicate well location X.

ADDITIONAL INFORMATION

A series of horizontal lines for providing additional information.

If more than one screen, show locations of each on sketch.