

MARION
 N 56
 11-2-71

MISSISSIPPI
 BOARD OF WATER COMMISSIONERS
 416 North State Street
 Jackson, Mississippi 39201

CODED

WATER WELL DRILLERS LOG

11-2-71 19 Red Industrial Water Well Marion
 date well completed firm name county well located

LANDOWNER: Edward F. Branch
Rt. 2, Fay Worth
Miss.
 (mailing address)

WELL LOCATION:
 sec 30 T 2 N R 13 E
0.16 miles South of Fay Worth
 (distance) (direction) (nearest town)

WELL PURPOSE: Home
 (home, irrigation, municipal, industrial)

WELL COMPLETION DATA:
 (1) diameter (inches) 4"
 (2) total depth (feet) 203
 (3) static water level (feet) 90 below above
 top of ground.
 (4) casing PVC, 203, 193'
 (material) (depth)
4" if telescope see back.
 (size)
 (5) screen 10 ft, 193
 (length) (depth to top)
0.12 PVC
 (size) (material)
 (6) pump 1/2 8
 (HP) (yield gpm)
220 AC
 (type power)
 (7) electric log Yes
 (yes or no)
 (organization running log)
 (8) how well bottom plugged: 4" PVC at 2' sand above back Wash

Description of formations encountered	from	to
<u>Top Clay</u>	<u>1</u>	<u>20</u>
<u>Top Sand</u>	<u>20</u>	<u>60</u>
<u>Gravel</u>	<u>60</u>	<u>62</u>
<u>Red Pipe Clay</u>	<u>62</u>	<u>67</u>
<u>White sand</u>	<u>67</u>	<u>120</u>
<u>Blue Chalk</u>	<u>120</u>	<u>155</u>
<u>White Silty sand</u>	<u>155</u>	<u>173</u>
<u>Reddish sand</u>	<u>173</u>	<u>203</u>

CODED


NOV 22 1971

MISS. BD. OF
WATER CONTROL

DRILLERS REMARKS: Well set at 120 ft. was not enough water for well.

If well telescopes please
sketch and show depths.

GROUND LEVEL

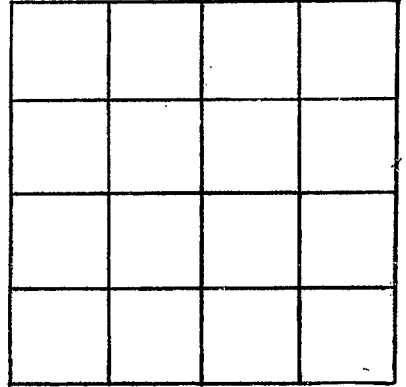

SECTION _____

Please indicate well location X.

ADDITIONAL INFORMATION

If more than one screen,
show locations of each on sketch.