

MARION
N 58
8-4-71

MISSISSIPPI
BOARD OF WATER COMMISSIONERS
416 North State Street
Jackson, Mississippi 39201

FEB - 7 1972

WATER WELL DRILLERS LOG

CODED

8-4-1972 date well completed

Dean Driner Drilling firm name


Marion county well located

LANDOWNER:	description of formations encountered	from	to
(mailing address)			
Jerry Johnson	Top Soil	0	1'
Rt. 2 Foxworth, Miss	Clay	1	14'
(mailing address)	gravel	14	35'
WELL LOCATION:	Sand	35	68'
sec. 1 T. 2 R. 12	Chalk	68	82'
11 miles S.W. of Columbia	Shell	82	105'
(distance) (direction) (nearest town)	gravel	105	148
WELL PURPOSE: Home	Chalk	140	163'
(home, irrigation, municipal, industrial)	Sand & Gravel	163	177'
WELL COMPLETION DATA:	Water Sand	177	225'
(1) diameter (inches) 4"			
(2) total depth (feet) 225'			
(3) static water level (feet) 123' below top of ground			
(4) casing Plastic 215' (material) (depth)			
(size) If telescope see back.			
(5) screen 10' 215' (length) (depth to top)			
4" Plastic (size) (material)			
(6) pump 3/4 (HP) (yield gpm)			
(type power)			
(7) electric log (yes or no)			
(organization running log)			
(8) how well bottom plugged			
DRILLERS REMARKS:			

CODED

If well telescopes please sketch and show depths.

GROUND LEVEL

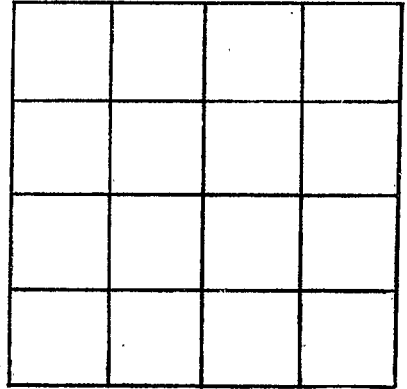

SECTION _____

Please indicate well location X.

ADDITIONAL INFORMATION

If more than one screen, show locations of each on sketch.