

MARION
N 60
4-72

MISSISSIPPI
BOARD OF WATER COMMISSIONERS
416 North State Street
Jackson, Mississippi 39201

WATER WELL DRILLERS LOG

CODED

April 1972
date well completed

E.B. Sherrard
firm name

Marion
county well located

LANDOWNER:

Shelton Jurnage

Jaywath, Miss.
(mailing address)

description of formations encountered

description of formations encountered	from	to
VERY SANDY		
CLAY BEDDING	0	70
TOUGH GRAVEL	70	120
REA GR. & SAND	120	140

WELL LOCATION:

sec 23 T 2 N R 13 E
23 S W
8 miles S Columbia
(distance) (direction) (nearest town)

WELL PURPOSE:

(Home) Irrigation, municipal, industrial

WELL COMPLETION DATA:

- diameter (inches) 4"
- total depth (feet) 140'
- static water level (feet) 90 below top of ground.
- casing pl. 130' (material) (depth)
4" (size) if telescope see back.
- screen 10' (length) (depth to top)
4" (size) pl. (material)
- pump 3/4 (HP) 18 (yield gpm)
E (type power)
- electric log (yes or no)
- how well bottom plugged BLW

CODED


JUL 26 1972

DRILLERS REMARKS:

MISS. REG.
WATER (LAW)

If well telescopes please sketch and show depths.

GROUND LEVEL

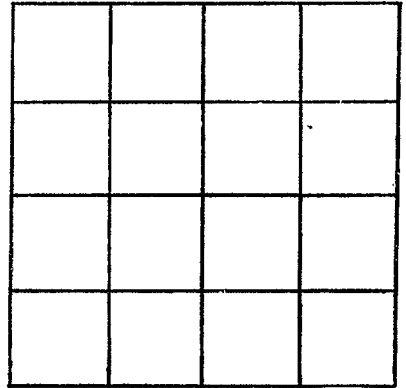

SECTION _____

Please indicate well location X.

ADDITIONAL INFORMATION

If more than one screen,
show locations of each on sketch.