

MARION
N62
5-72

MISSISSIPPI
BOARD OF WATER COMMISSIONERS
416 North State Street
Jackson, Mississippi 39201

WATER WELL DRILLERS LOG

CODED

May 1972
date well completed

F. B. Sheppard
firm name

Marion
county well located

LANDOWNER:

Felder Holmes

Kokomo, Miss
(mailing address)

description of formations
encountered

SAND & GRAVEL

from

to

0 145

WELL LOCATION:

sec. 4 T. 20 N. R. 12 E

11 miles SW Columbia
(distance) (direction) (nearest town)

WELL PURPOSE:

(home) irrigation, municipal, industrial

WELL COMPLETION DATA:

(1) diameter (inches) 4"
(2) total depth (feet) 145'
(3) static water level (feet) 80' ^{below} above top of ground.

(4) casing pl. 135'
(material) (depth)
4" if telescope see back.
(size)

(5) screen 10' pl.
(length) (depth to top)
4" (size) (material)

(6) pump 3/4 20
(HP) (yield gpm)
E
(type power)

(7) electric log (yes or no)

(organization running log)

(8) how well bottom plugged BWV

CODED


JUN 28 1972

DRILLERS REMARKS:

MISS. BD. OF
STATE WATER

If well telescopes please sketch and show depths.

GROUND LEVEL

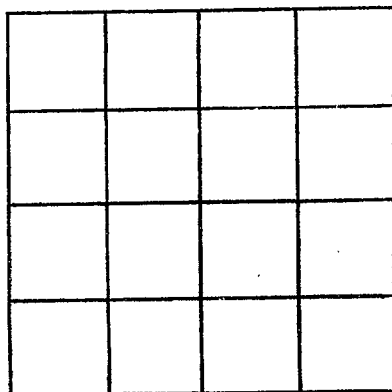

SECTION _____

Please indicate well location X.

ADDITIONAL INFORMATION

If more than one screen, show locations of each on sketch.