

MISSISSIPPI  
BOARD OF WATER COMMISSIONERS  
416 North State Street  
Jackson, Mississippi 39201

**CODED**

WATER WELL DRILLERS LOG

MARION  
N 64  
6-72

June 1972 E.B. Sheppard Marion  
date well completed firm name county well located

LANDOWNER:

Podie Mc Cain  
Jaywards, Miss  
(mailing address)

WELL LOCATION:

sec 12 T 2N R 12E  
S  
9 miles SW of Columbia  
(distance) (direction) (nearest town)

WELL PURPOSE:

(home) irrigation, municipal, industrial

WELL COMPLETION DATA:

- (1) diameter (inches) 2"
- (2) total depth (feet) 120'
- (3) static water level (feet) 78 below above top of ground.
- (4) casing pl. 115'  
(material) (depth)  
2" if telescope see back.  
(size)
- (5) screen 5' pl.  
(length) (depth to top)  
2" (size) (material)
- (6) pump 1 7  
(HP) (yield gpm)  
e  
(type power)
- (7) electric log (yes or no)  
(organization running log)
- (8) how well bottom plugged BWV

description of formations encountered

description of formations encountered	from	to
<u>RED CLAY</u>		
<u>GRAVEL</u>	<u>0</u>	<u>60'</u>
<u>STRAKS GR.</u>		
<u>SAND</u>	<u>60'</u>	<u>100'</u>
<u>SMALL PEAGR.</u>		
<u>COARSE SAND</u>	<u>100'</u>	<u>120'</u>

**CODED**


JUL 28 1972

DRILLERS REMARKS:

MISS. BD. OF  
WATER COM.

If well telescopes please sketch and show depths.

GROUND LEVEL

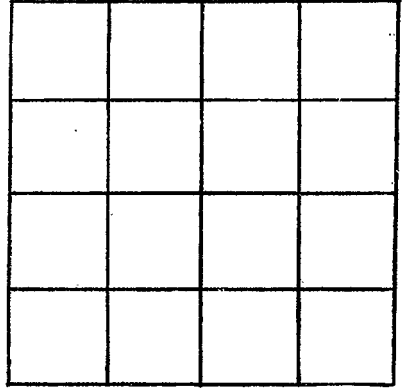

SECTION \_\_\_\_\_

Please indicate well location X.

ADDITIONAL INFORMATION

If more than one screen,  
show locations of each on sketch.