

MARION
N 65
9-22-72

MISSISSIPPI
BOARD OF WATER COMMISSIONERS
416 North State Street
Jackson, Mississippi 39201

WATER WELL DRILLERS LOG

9-22 1972 date well completed
F. L. ... firm name
CODING County well located

LANDOWNER:

Ruby Bailey
R.R. 4, Fawcett Miss.
(mailing address)

description of formations encountered

from to

Red clay	0	20
Red gravel	20	75
White & Blue Clay	75	182
Coarse sand & gravel	182	199

WELL LOCATION:

sec. X T. 2 R. 12
2 1/2 miles South of Kokomo
(distance) (direction) (nearest town)

WELL PURPOSE: Home
(home, irrigation, municipal, industrial)

WELL COMPLETION DATA:

- (1) diameter (inches) 4
- (2) total depth (feet) 199
- (3) static water level (feet) 20 below above top of ground.
- (4) casing plastic, 191,
(material) (depth)
4 if telescope see back.
(size)
- (5) screen 3, 191
(length) (depth to top)
4 ; plastic
(size) (material)
- (6) pump 1/2 10
(HP) (yield gpm)
600
(type power)
- (7) electric log no
(yes or no)
(organization running log)
- (8) how well bottom plugged wood plug

CODING


OCT 17 1972

DRILLERS REMARKS:

MISS. HD.
WATER C.

If well telescopes please sketch and show depths.

GROUND LEVEL

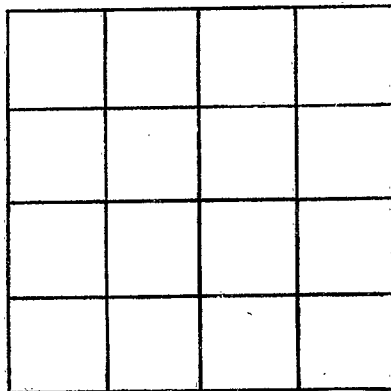

2 1/2 miles from our map -

Rutledge SECTION _____

Please indicate well location X.

ADDITIONAL INFORMATION

If more than one screen, show locations of each on sketch.