

MARION  
N 66  
12-72

MISSISSIPPI  
BOARD OF WATER COMMISSIONERS  
416 North State Street  
Jackson, Mississippi 39201

CODED

WATER WELL DRILLERS LOG


Dec. 1972 E.B. Sheppard Marion  
date well completed firm name county well located

LANDOWNER:	description of formations encountered	from	to
Gary Roberts Fayworth, Miss (mailing address)	LOOSE SANDY RED CLAY SAND & GR. MIXED	0	150 150 225
WELL LOCATION: sec. 7 T 20 N R 13 E 9 miles S of Fayworth (distance) (direction) (nearest town)			
WELL PURPOSE: (home, irrigation, municipal, industrial)			
WELL COMPLETION DATA: (1) diameter (inches) 4 1/2" (2) total depth (feet) 230' (3) static water level (feet) 170' below above top of ground. (4) casing pl. 200' (material) (depth) 4 1/2" (size) if telescope see back. (5) screen 10' (length) (depth to top) 4 1/2" (size) pl. (material) (6) pump 3/4 (HP) 15 (yield gpm) E (type power) (7) electric log (yes or no) (organization running log) (8) how well bottom plugged BWV			
DRILLERS REMARKS:			

CODED

If well telescopes please sketch and show depths.

GROUND LEVEL

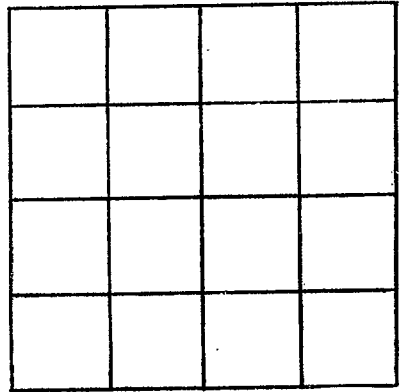

SECTION \_\_\_\_\_

Please indicate well location X.

ADDITIONAL INFORMATION

If more than one screen, show locations of each on sketch.