

**MARION**  
**N 67.**  
**12-72**

MISSISSIPPI  
 BOARD OF WATER COMMISSIONERS  
 416 North State Street  
 Jackson, Mississippi 39201

**INDEXED**

**WATER WELL DRILLERS LOG**


Dec 1972 E.B. Sherrard Marion  
 date well completed firm name county well located

LANDOWNER:	description of formations encountered	from	to
<u>Gladys Payton</u> <u>Foxworth, Miss</u> (mailing address)		<u>B.F.P CLAY</u> <u>LOOSE GRAVEL</u> <u>+ CLAY STREAKS</u> <u>COARSE SAND</u> <u>+ SMALL PEGR.</u>	<u>0</u>
<b>WELL LOCATION:</b>			
sec <u>14</u> T. <u>20</u> N. R. <u>13</u> E. S W			
<u>8</u> miles <u>S</u> <u>Foxworth</u> (distance) (direction) (nearest town)			
<b>WELL PURPOSE:</b> (home, irrigation, municipal, industrial)			
<b>WELL COMPLETION DATA:</b>			
(1) diameter (inches) <u>2"</u>			
(2) total depth (feet) <u>200</u>			
(3) static water level (feet) <u>155</u> <sup>below</sup> above top of ground.			
(4) casing <u>pl.</u> <u>195'</u> (material) (depth)			
<u>2"</u> if telescope see back. (size)			
(5) screen <u>5'</u> (length) (depth to top)			
<u>2"</u> <u>pl.</u> (size) (material)			
(6) pump <u>2</u> <u>6</u> (HP) (yield gpm)			
<u>E</u> (type power)			
(7) electric log <u>(yes or no)</u>			
(organization running log)			
(8) how well bottom plugged <u>BWV</u>			
<b>DRILLERS REMARKS:</b>			

**INDEXED**

If well telescopes please sketch and show depths.

GROUND LEVEL

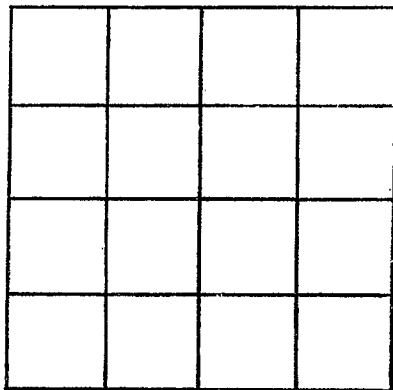

SECTION \_\_\_\_\_

Please indicate well location X.

ADDITIONAL INFORMATION

If more than one screen,  
show locations of each on sketch.