

MARION
N 68
1-73

MISSISSIPPI
BOARD OF WATER COMMISSIONERS
416 North State Street
Jackson, Mississippi 39201

WATER WELL DRILLERS LOG

CODED

Jan 19 73 E.B. Sherrard Marion
date well completed firm name county well located

LANDOWNER:	description of formations encountered	from	to
John Williams	LOOSE RED SANDY CLAY	0	60
Rt. 2 - Sylertown, Miss. (mailing address)	SAND & GR.	60	134

WELL LOCATION:
sec. 9 T. 2 N. R. 12 E.
10 miles SW of Fayetteville
(distance) (direction) (nearest town)

WELL PURPOSE:
(home, irrigation, municipal, industrial)


- WELL COMPLETION DATA:
- (1) diameter (inches) 4"
 - (2) total depth (feet) 134'
 - (3) static water level (feet) 60' below top of ground.
 - (4) casing (material) pl. (depth) 124'
4" (size) if telescope see back.
 - (5) screen (length) 10' (depth to top)
4" (size) (material) pl.
 - (6) pump 3/4 (HP) 15 (yield gpm)
E. (type power)
 - (7) electric log (yes or no)
 - (organization running log)
 - (8) how well bottom plugged BWV

CODED

DRILLERS REMARKS:

If well telescopes please sketch and show depths.

GROUND LEVEL

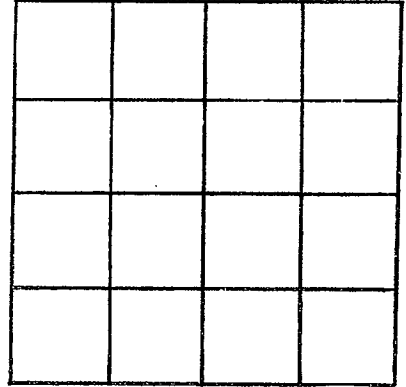

SECTION _____

Please indicate well location X.

ADDITIONAL INFORMATION

If more than one screen,
show locations of each on sketch.