

MARION
N 69
5-73

MISSISSIPPI
BOARD OF WATER COMMISSIONERS
416 North State Street
Jackson, Mississippi 39201

CODED

WATER WELL DRILLERS LOG

May 19 73 E. B. Sheppard Marion
date well completed firm name county well located

LANDOWNER:
Robert G. Martin
Foxworth Miss.
(mailing address)

description of formations encountered	from	to
GRAY CLAY	0	20
MEDIUM GRAVEL	"	"
CLAY	20	38
DIA GRAYEL	38	48

WELL LOCATION:
sec. 11 T. 20^N R. 13^E
S W
6 miles S Foxworth
(distance) (direction) (nearest town)

WELL PURPOSE:
 Home Irrigation, municipal, industrial

WELL COMPLETION DATA:

(1) diameter (inches) 4"

(2) total depth (feet) 48'

(3) static water level (feet) 32' below top of ground.

(4) casing (material) (depth) 38'

4" (size) If telescope see back.

(5) screen (length) (depth to top) 10'

4" (size) (material) (depth) 15'

(6) pump (HP) (yield gpm) 2 15

(type power) 2

(7) electric log (yes or no) (no)

(organization running log)


(8) how well bottom plugged BWV

CODED

DRILLERS REMARKS:

If well telescopes please sketch and show depths.

GROUND LEVEL

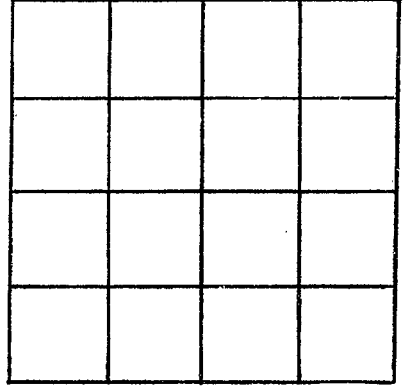

SECTION _____

Please indicate well location X.

ADDITIONAL INFORMATION

If more than one screen,
show locations of each on sketch.