

MARION
N 70
6-73

MISSISSIPPI
BOARD OF WATER COMMISSIONERS
416 North State Street
Jackson, Mississippi 39201

CODED

WATER WELL DRILLERS LOG

June 1973 E.B. Sheppard Marion
date well completed firm name county well located

LANDOWNER:

Lenora Pittman
Rt. 2 - Julestown
(mailing address)

description of formations
encountered

SANDY RED
CLAY
GRAVEL & SAND
from to
0 100
100 142

WELL LOCATION:

sec. 16 T. 2 N. R. 12 E.
S
12 miles SW Columbia
(distance) (direction) of (nearest town)

WELL PURPOSE:

(home, irrigation, municipal, industrial)

CODED

WELL COMPLETION DATA:

- (1) diameter (inches) 2"
(2) total depth (feet) 142'
(3) static water level (feet) 90' ^{below} _{above} top of ground.
(4) casing pl. 137'
(material) (depth)
2" if telescope see back.
(size)
(5) screen 5'
(length) (depth to top)
2" pl.
(size) (material)
(6) pump 1 1/2 7
(HP) (yield gpm)
E
(type power)
(7) electric log (yes or no)

(organization running log)

(8) how well bottom plugged BLW


NOV 10 1973

MISS. BD. OF
WATER COMMISSIONERS

DRILLERS REMARKS:

If well telescopes please
sketch and show depths.

GROUND LEVEL

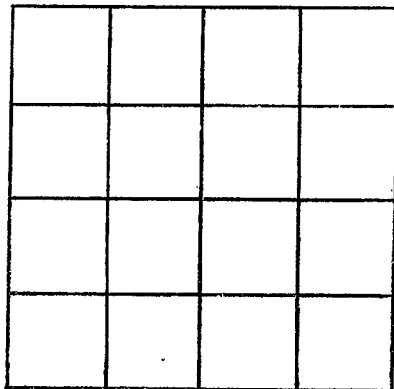

SECTION _____

Please indicate well location X.

ADDITIONAL INFORMATION

If more than one screen,
show locations of each on sketch.