

MARION
N71
C-73

MISSISSIPPI
BOARD OF WATER COMMISSIONERS
416 North State Street
Jackson, Mississippi 39201

CODED

WATER WELL DRILLERS LOG

JUNE 1973
date well completed

E.B. SHEPARD
firm name

MARION
county well located

LANDOWNER:	description of formations encountered	from	to
R. C. JACKSON	RED SANDY CLAY	0	80
PT. 1 - SANDY HOOK, MISS. (mailing address)	STREAKS DAY GRAVEL WITH SAND	80	130
WELL LOCATION: sec 23 T 2 N S R 13 E	PEA GR. & SAND WITH STAK. RED CLAY	130	160
9 miles S COLUMBIA (distance) (direction) (nearest town)	PURE PEA GR & COARSE SAND MIXED	160	178
WELL PURPOSE: (Home irrigation, municipal, industrial)			
WELL COMPLETION DATA:			
(1) diameter (inches) 2"			
(2) total depth (feet) 178'			
(3) static water level (feet) 126' below top of ground.			
(4) casing PL. 173' (material) (depth)			
2" (size) if telescope see back.			
(5) screen 5' (length) (depth to top)			
2" (size) PL. (material)			
(6) pump 1 1/2 (HP) 7 (yield gpm)			
E (type power)			
(7) electric log (yes) or (no)			
(organization running log)			
(8) how well bottom plugged B.W.V			
DRILLERS REMARKS:			


CODED

APR 10 1973

MISS. BD. OF
WATER COMMISSIONERS

If well telescopes please sketch and show depths.

GROUND LEVEL

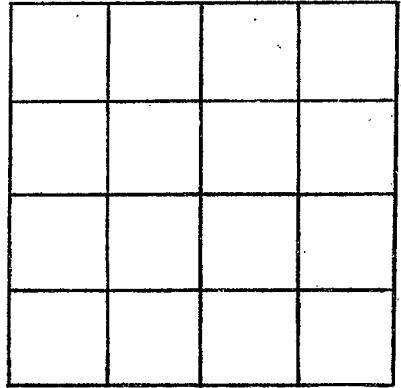

SECTION _____

Please indicate well location X.

ADDITIONAL INFORMATION

If more than one screen,
show locations of each on sketch.