

MARION
N72
9/73

MISSISSIPPI
BOARD OF WATER COMMISSIONERS
416 North State Street
Jackson, Mississippi 39201

CODED

WATER WELL DRILLERS LOG

Sept. 73 E. B. Sherrard Marion
date/well completed firm name county/well located

LANDOWNER:

West Mary Moody
Sandy Hook
(mailing address)

description of formations encountered

from to

SAND - SAND 0 40
SAND + PEAB. 40 70

WELL LOCATION:

sec 25 T2N R13E
8 1/2 miles S of Joplin
(distance) (direction) (nearest town)

WELL PURPOSE:

(home, irrigation, municipal, industrial)

WELL COMPLETION DATA:

- (1) diameter (inches) 2"
- (2) total depth (feet) 70'
- (3) static water level (feet) 29' below top of ground.
- (4) casing pl. 65' (material) (depth)
2" (size) if telescope see back.
- (5) screen 5' (length) (depth to top)
2" (size) pl. (material)
- (6) pump 3 (HP) 7 (yield gpm)
E (type power)
- (7) electric log (yes or no) (no)

CODED

(organization running log)


(8) how well bottom plugged BWV

DRILLERS REMARKS:

RECORDED
INDEXED
FEB 1974
MISSISSIPPI BOARD OF WATER COMMISSIONERS

If well telescopes please sketch and show depths.

GROUND LEVEL

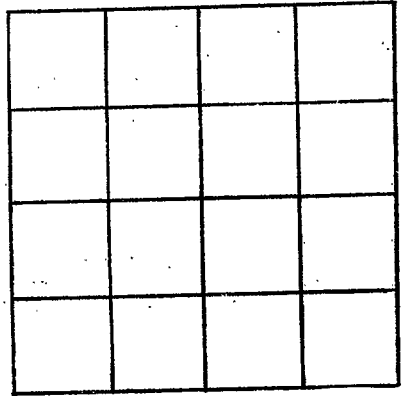

SECTION _____

Please indicate well location X.

ADDITIONAL INFORMATION

Lined area for additional information, consisting of approximately 20 horizontal lines.

If more than one screen, show locations of each on sketch.