

MARION
N 74
8/73

MISSISSIPPI
BOARD OF WATER COMMISSIONERS
416 North State Street
Jackson, Mississippi 39201

CODED

WATER WELL DRILLERS LOG

Aug 1973 E.B. Sheppard Marion
date well completed firm name county well located

LANDOWNER:
Silton Peak
Foyworth, Miss
(mailing address)

description of formations encountered	from	to
SAND & GRAVEL	0	82'


WELL LOCATION:
sec 13 T 2 N R 13 E
S W
7 miles S Foyworth
(distance) (direction) (nearest town)

WELL PURPOSE:
(home, irrigation, municipal, industrial)

- WELL COMPLETION DATA:
- (1) diameter (inches) 2"
 - (2) total depth (feet) 82'
 - (3) static water level (feet) 38' ^{below} top of ground
 - (4) casing pl. 77' (material) (depth)
2" if telescope see back. (size)
 - (5) screen 5' (length) (depth to top)
2" (size) pl. (material)
 - (6) pump 1 (HP) 8 (yield gpm)
E (type power)
 - (7) electric log (yes or no)
 - (8) how well bottom plugged BWV

CODED


DRILLERS REMARKS:

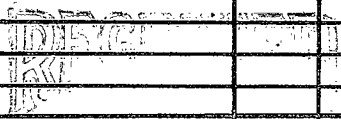

EFB 8/1/73

If well telescopes please sketch and show depths.

GROUND LEVEL

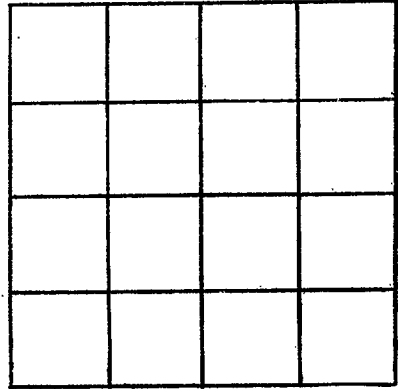

SECTION _____

Please indicate well location X.

ADDITIONAL INFORMATION

If more than one screen,
show locations of each on sketch.