

MARISON
N 75
11/73

MISSISSIPPI
BOARD OF WATER COMMISSIONERS
416 North State Street
Jackson, Mississippi 39201 CODED

WATER WELL DRILLERS LOG


Nov. 1973 E. B. Sheppard Marion
date well completed firm name county well located

LANDOWNER:	description of fomations encountered	from	to
Gary Hammond Rt. 1 - Sandy Hook, Miss. (mailing address)	SAND + GRAVEL	0	71
WELL LOCATION: sec 25 T 2 N R 13 E 10 miles S of Col. (distance) (direction) (nearest town)			
WELL PURPOSE: (Home) Irrigation, municipal, industrial			
WELL COMPLETION DATA:			
(1) diameter (inches) 2"			
(2) total depth (feet) 71'			
(3) static water level (feet) 40' below top of ground.			
(4) casing (material) pl. (depth) 66' 2" (size) if telescope see back.			
(5) screen (length) 5' (depth to top)			
2" (size) pl. (material)			
(6) pump (HP) 7 (yield gpm) E. (type power)			
(7) electric log (yes or no)			
(organization running log)			
(8) how well bottom plugged BWV			
DRILLERS REMARKS:			

CODED

If well telescopes please sketch and show depths.

GROUND LEVEL

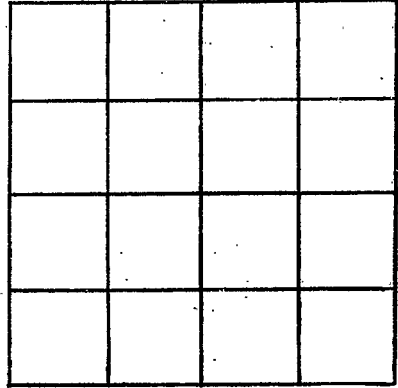

SECTION _____

Please indicate well location X.

ADDITIONAL INFORMATION

If more than one screen, show locations of each on sketch.