

MARION
N 76
3-2-74

MISSISSIPPI
BOARD OF WATER COMMISSIONERS
416 North State Street
Jackson, Mississippi 39201

WATER WELL DRILLERS LOG
GRINER - GINN

CODED

3-2 1974
date well completed

firm name

Marion
county well located


LANDOWNER:	description of formations encountered	from	to
Fletcher Fontenberry	Top Soil	0	1
R. 2 Foxworth (mailing address)	Clay Gravel Chalk Sand	1 149 514 126	49 84 126 155
WELL LOCATION:			
sec. 9 T 20 N R 12 E S W 16 miles W of Foxworth (distance) (direction) (nearest town)			
WELL PURPOSE: Home (home, irrigation, municipal, industrial)			
WELL COMPLETION DATA:			
(1) diameter (inches) 4"	CODED		
(2) total depth (feet) 155			
(3) static water level (feet) 112 below top of ground.			
(4) casing plastic 145 (material) (depth)			
4" If telescope see back. (size)			
(5) screen 10' 145 (length) (depth to top)			
4" plastic (size) (material)			
(6) pump 3/4 10 (HP) (yield gpm)			
elec. (type power)			
(7) electric log 150 (yes or no)			
NO (organization running log)			
(8) how well bottom plugged B.W. valve			
DRILLERS REMARKS:			

REGISTERED
MAY 23 1974

MISS. Bd. OF WATER

If well telescopes please sketch and show depths.

GROUND LEVEL

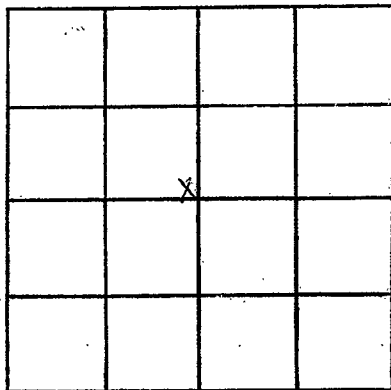

SECTION 9

Please indicate well location X.

ADDITIONAL INFORMATION

Lined area for additional information.

If more than one screen, show locations of each on sketch.