

MARION
N 77
12-18-73

MISSISSIPPI
BOARD OF WATER COMMISSIONERS
416 North State Street
Jackson, Mississippi 39201

CODEN

WATER WELL DRILLERS LOG

12-18-73 1973 GRINER - GINN Marion
date well completed firm name county well located

LANDOWNER:
Otis Byrd
Rt. 2 Jayworth
(mailing address) Miss.

description of formations encountered	from	to
Top Soil	0	3
Clay	3	18
Sand & Gravel	18	94
Clay	94	158
Sand	158	235

WELL LOCATION:
sec. 22 T. 20 S. R. 13 E.
13 miles S of Jayworth
(distance) (direction) (nearest town)

CODED

WELL PURPOSE: haul
(home, irrigation, municipal, industrial)


- WELL COMPLETION DATA:
- (1) diameter (inches) 4"
 - (2) total depth (feet) 235
 - (3) static water level (feet) 170 below top of ground.
 - (4) casing plastic, 225
(material) (depth)
4"
(size) If telescope see back.
 - (5) screen 10', 225
(length) (depth to top)
4"
(size) (material)
plastic
 - (6) pump 3/4 8
(HP) (yield gpm)
elec
(type power)
 - (7) electric log NO
(yes or no)
NO
(organization running log)
 - (8) how well bottom plugged
B.W. Valve

DRILLERS REMARKS:

RECORDED
INDEXED
MAY 23 1974
MISS. BD. OF WATER

If well telescopes please sketch and show depths.

GROUND LEVEL

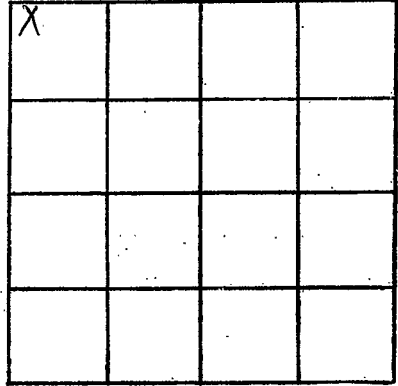

SECTION 23

Please indicate well location X.

ADDITIONAL INFORMATION

If more than one screen, show locations of each on sketch.