

MARION
N 78
5-8-74

MISSISSIPPI
 BOARD OF WATER COMMISSIONERS
 416 North State Street
 Jackson, Mississippi 39201

CODED

WATER WELL DRILLERS LOG

5/8/1974 date well completed Eassey Staffed Wells firm name Marion county well located

LANDOWNER: Harold Hunt
Rt. 1
Sandy Hook, Miss
 (mailing address)

description of formations encountered	from	to
<u>Top Soil + Chalk</u>	<u>0</u>	<u>3.1</u>
<u>Sand + Gravel</u>	<u>3.1</u>	<u>9.0</u>


WELL LOCATION:
 sec. 10 T. 2 N. R. 12 E.
1/2 miles North of Phenoer
 (distance) (direction) (nearest town)

WELL PURPOSE: home
 (home, irrigation, municipal, industrial)

CODED

- WELL COMPLETION DATA:
- (1) diameter (inches) 4 in
 - (2) total depth (feet) 9.0 ft.
 - (3) static water level (feet) 7.0 ft. ^{below} _{above} top of ground.
 - (4) casing plastic, 8.0
 (material) (depth)
4 in if telescope see back.
 (size)
 - (5) screen 10 ft., 8.0 ft.
 (length) (depth to top)
4 in, plastic
 (size) (material)
 - (6) pump 1/2 hp, 360 gal/hr.
 (HP) (yield/gpm)
Electric
 (type power)
 - (7) electric log yes or no
 - (8) how well bottom plugged R.W.U.

DRILLERS REMARKS:
Clevie Duman

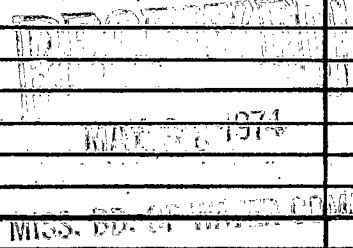

If well telescopes please sketch and show depths.

GROUND LEVEL

		8	

SECTION _____

Please indicate well location X.

ADDITIONAL INFORMATION

If more than one screen, show locations of each on sketch.