

MARION
N 80
2174

MISSISSIPPI
BOARD OF WATER COMMISSIONERS
416 North State Street
Jackson, Mississippi 39201

CODED

WATER WELL DRILLERS LOG

Feb. 27 1974 E.B. Sheppard Marion
date well completed firm name county well located

LANDOWNER:

Junior Piggatt
Kokomo, Miss.
(mailing address)

description of formations encountered

from to

RED SANDY CLAY GR.	0	80'
GRAVEL + PEAS GR.	80'	120'
PEAS GR. + SAND	120'	142'

WELL LOCATION:

sec 16 T 2 N R 12 E
4 miles S of Kokomo
(distance) (direction) (nearest town)

WELL PURPOSE:

(home) Irrigation, municipal, industrial

CODED

WELL COMPLETION DATA:

- (1) diameter (inches) 2
- (2) total depth (feet) 142'
- (3) static water level (feet) 95' ^{6.12} above top of ground.
- (4) casing pl. 137'
(material) (depth)
2" if telescope see back.
(size)
- (5) screen 5'
(length) (depth to top)
2" pl.
(size) (material)
- (6) pump 1 1/2 8
(HP) (yield gpm)
E
(type power)
- (7) electric log (yes or no)

(organization running log)

(8) how well bottom plugged BLW


DRILLERS REMARKS:

RECEIVED
MARCH 1 1974

MISS. BD. OF WATER COMMISSIONERS

If well telescopes please sketch and show depths.

GROUND LEVEL

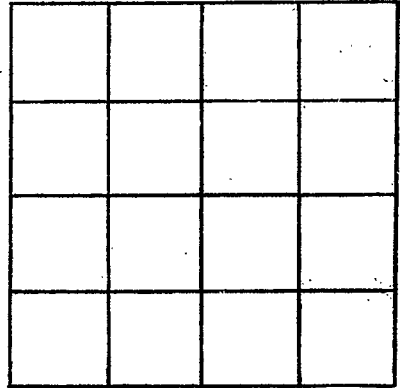

SECTION _____

Please indicate well location X.

ADDITIONAL INFORMATION

If more than one screen, show locations of each on sketch.