

MARION
 N 82
 1/74

MISSISSIPPI
 BOARD OF WATER COMMISSIONERS
 416 North State Street
 Jackson, Mississippi 39201

CODED

WATER WELL DRILLERS LOG

Jan. 1974 E. B. Sheward Marion
 date well completed firm name county well located

LANDOWNER:

David Pittman
 Rt. 2 - Foxworth, Miss.
 (mailing address)

description of formations encountered

from to

RED SANDY CLAY 0 80'
 GRAY STRKS CLAY WITH SAND 80' 160'
 FINE SAND 160' 180'
 VERY COARSE SAND 180' 202'

WELL LOCATION:

sec. 5 T. 20 N R. 13 E
 S W
 5 miles SW Foxworth
 (distance) (direction) (nearest town)

WELL PURPOSE:

(home) irrigation, municipal, industrial

WELL COMPLETION DATA:

- (1) diameter (inches) 4"
- (2) total depth (feet) 202'
- (3) static water level (feet) 146' ^{below} _{above} top of ground.
- (4) casing pl. 192'
 (material) (depth)
 4" If telescope seo back.
 (size)
- (5) screen 10'
 (length) (depth to top)
 4" pl.
 (size) (material)
- (6) pump 1 HP 20
 (type power) (yield gpm)
- (7) electric log (yes or no)

(organization running log)

(8) how well bottom plugged B/W


RECEIVED
 JUL - 1 1974

DRILLERS REMARKS:

MISS. RD. OF WATER COMRS

If well telescopes please sketch and show depths.

GROUND LEVEL

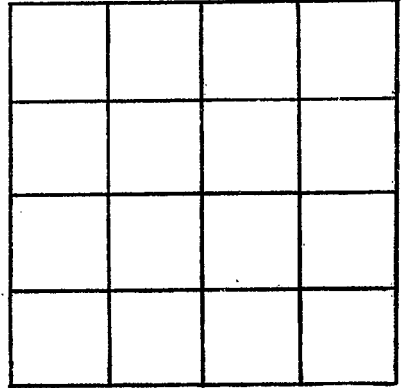

SECTION _____

Please indicate well location X.

ADDITIONAL INFORMATION

If more than one screen, show locations of each on sketch.