

MARION
N 83
1/74

MISSISSIPPI
BOARD OF WATER COMMISSIONERS
416 North State Street
Jackson, Mississippi 39201

CODED

WATER WELL DRILLERS LOG

Jan. 1974 E.B. Sheppard Marion
date well completed firm name county/well located

LANDOWNER:
Mrs. Mylbia Williamson
Rt. 3 - Lybertown, Miss.
(mailing address)

description of formations encountered	from	to
SANDY BED CLAY & GR.		
MIXED	0	60'
COARSE PEA GR SAND	60	68'

WELL LOCATION:
sec. 4 T 2 N R 12 E
S W
8 miles SW of Joplin
(distance) (direction) (nearest town)

WELL PURPOSE:
(home, irrigation, municipal, industrial)

- WELL COMPLETION DATA:
- (1) diameter (inches) 2"
 - (2) total depth (feet) 68'
 - (3) static water level (feet) 30' ^{below} above top of ground.
 - (4) casing pl. 63'
(material) (depth)
2"
(size) If telescope see back.
 - (5) screen 5'
(length) (depth to top)
2" pl.
(size) (material)
 - (6) pump 1/2 7
(HP) (yield gpm)
E
(type power)
 - (7) electric log (yes or no) no
(organization running log)
 - (8) how well bottom plugged BWV

CODED


RECEIVED
JUL - 1 1974

MISS. BD. OF WATER COMMISSIONERS

DRILLERS REMARKS:

If well telescopes please sketch and show depths.

GROUND LEVEL

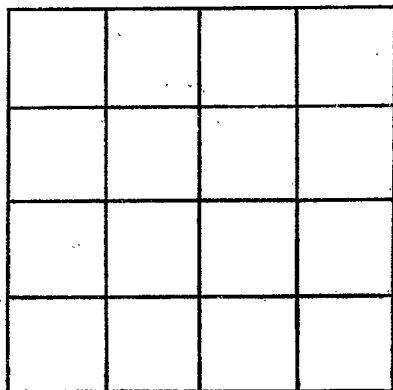

SECTION _____

Please indicate well location X.

ADDITIONAL INFORMATION

If more than one screen, show locations of each on sketch.