

MARION
N 84
11-21-74

MISSISSIPPI
BOARD OF WATER COMMISSIONERS
416 North State Street
Jackson, Mississippi 39201

CODED

WATER WELL DRILLERS LOG

11-21-74
date well completed


74 Brewer - GINN
firm name

Marion
county well located

LANDOWNER:	description of formations encountered	from	to
SUSIE GREEN Kokomo, (mailing address) MISS	Top Soil clay a half sand	0 1 38 70 70	1 38 70 100
WELL LOCATION: sec. <u>32</u> T <u>2</u> N R <u>12</u> E <u>2</u> miles <u>A</u> of <u>Kokomo</u> (distance) (direction) (nearest town)			
WELL PURPOSE: <u>None</u> (home, irrigation, municipal, industrial)	CODED		
WELL COMPLETION DATA: (1) diameter (inches) <u>2"</u> (2) total depth (feet) <u>100</u> (3) static water level (feet) <u>15</u> below top of ground. (4) casing <u>plastic</u> , <u>90</u> (material) (depth) <u>2"</u> (size) if telescope see back. (5) screen <u>10'</u> , <u>90</u> (length) (depth to top) <u>2"</u> , <u>plastic</u> (size) (material) (6) pump <u>1/2</u> (HP) (yield gpm) <u>elec.</u> (type power) (7) electric log <u>NO</u> (yes or no) <u>NO</u> (organization running log) (8) how well bottom plugged, <u>Bill Wade</u>	RECEIVED DEC 26 1974		
DRILLERS REMARKS:	MISS. BD. OF WATER COMMISSIONERS		

If well telescopes please sketch and show depths.

GROUND LEVEL

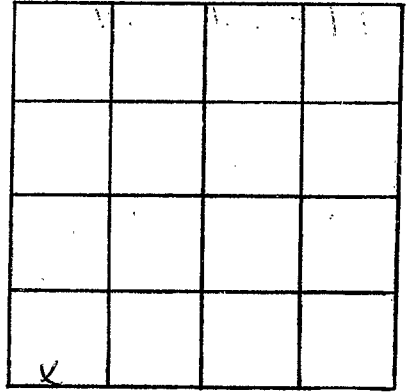

SECTION 32

Please indicate well location X.

ADDITIONAL INFORMATION

If more than one screen,
show locations of each on sketch.