

MARION
N 85
5-10-74

MISSISSIPPI
BOARD OF WATER COMMISSIONERS
416 North State Street
Jackson, Mississippi 39201

WATER WELL DRILLERS LOG

5-10 1974 Union - Ginn Marion
date well completed firm name county well located

LANDOWNER:
Lanny Cannuth
Kokomo, Miss.
(mailing address)

description of formations encountered	from	to
<u>top soil</u>	<u>0</u>	<u>1</u>
<u>clay</u>	<u>1</u>	<u>25</u>
<u>chab + clay</u>	<u>23</u>	<u>58</u>
<u>sand</u>	<u>58</u>	<u>83</u>

WELL LOCATION:
sec. 32 T. 2 N. R. 12 E. S. 5
1 miles sw of Kokomo
(distance) (direction) (nearest town)

WELL PURPOSE: Cattle
(home, irrigation, municipal, industrial)

WELL COMPLETION DATA:

(1) diameter (inches) 2"

(2) total depth (feet) 83

(3) static water level (feet) 40 below above top of ground.

(4) casing plastic, 73,
(material) (depth)
2" if telescope see back.
(size)

(5) screen 10', 73
(length) (depth to top)
2", plastic
(size) (material)

(6) pump 3, 8
(HP) (yield gpm)
gasoline
(type power)

(7) electric log No
(yes or no)
NO
(organization running log)

(8) how well bottom plugged
B.W. Valve

DRILLERS REMARKS:


CODED

DEC 26 1974

MISS. BO. OF WATER COMM.

If well telescopes please sketch and show depths.

GROUND LEVEL

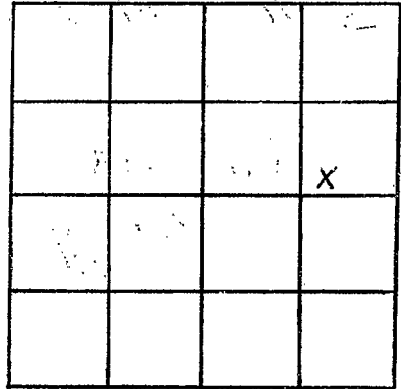

SECTION 32

Please indicate well location X.

ADDITIONAL INFORMATION

Multiple horizontal lines for handwritten notes, with some faint markings.

If more than one screen, show locations of each on sketch.