

MARION  
 N 43 86  
 6-30-75

MISSISSIPPI  
 BOARD OF WATER COMMISSIONERS  
 416 North State Street  
 Jackson, Mississippi 39201

CODED

WATER WELL DRILLERS LOG

Jan 30 1975 B. Woodward Drilling Marion  
 date well completed firm name county well located

LANDOWNER:  
 Mr. J. L. Ellard  
 SANDY HOOK, MISS.  
 (mailing address)


description of formations encountered	from	to
SAND AND GRAVEL		14'
CLAY	14'	21'
SAND AND GRAVEL	21'	130'

WELL LOCATION:  
 sec. 36 T 2 N R. 13 E 13 V  
3 miles NW of Sandy Hook  
 (distance) (direction) (nearest town)

WELL PURPOSE: Home  
 (home, irrigation, municipal, industrial)

- WELL COMPLETION DATA:
- diameter (inches) 4"
  - total depth (feet) 120'
  - static water level (feet) 110' below above top of ground.
  - casing PVC, 120'  
 (material) (depth)  
4"  
 (size) if telescope see back.
  - screen 10', 120'  
 (length) (depth to top)  
4", 1160 PVC  
 (size) (material)
  - pump 1 25  
 (HP) (yield gpm)  
230 VAC  
 (type power)
  - electric log NO  
 (yes or no)  
 (organization running log)
  - how well bottom plugged FLOAT-TYPE G.W.V.

CODED

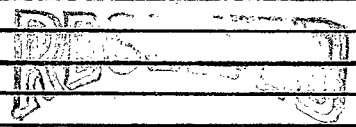


MAR - 3 1975

MISS. BD. OF WATER COMMISSIONERS

DRILLERS REMARKS:

If well telescopes please sketch and show depths.

GROUND LEVEL

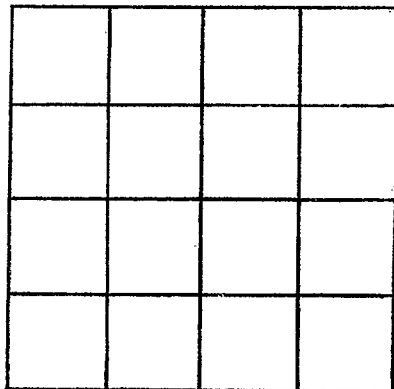

SECTION \_\_\_\_\_

Please indicate well location X.

ADDITIONAL INFORMATION

If more than one screen,  
show locations of each on sketch.