

Marion
N 87
4/75

MISSISSIPPI
BOARD OF WATER COMMISSIONERS
416 North State Street
Jackson, Mississippi 39201

CODED

WATER WELL DRILLERS LOG

April 1975
date well completed

E. B. Sheppard
firm name

Marion
county well located

LANDOWNER:

Robert Miller
Fayworth Ms.
(mailing address)

description of formations encountered

from to

LOOSE RED SANDY CLAY	0	70'
DRY GRAVEL	70	90'
CLAY STRKS.	90	120'
REA GR. & SAND	120	142'

WELL LOCATION:

sec 20 T 2 N R 13 E S
8.20 miles SW of Fayworth
(distance) (direction) (nearest town)

WELL PURPOSE:

(home, irrigation, municipal, industrial)

WELL COMPLETION DATA:

- (1) diameter (inches) 2"
- (2) total depth (feet) 142'
- (3) static water level (feet) 170' below top of ground. 110' above
- (4) casing (material) pl. (depth) 137'
- 2" (size) If telescope see back.
- (5) screen 5' (length) (depth to top)
- 2" (size) pl. (material)
- (6) pump 1/2 (HP) 6 (yield gpm)
- E (type power)
- (7) electric log (yes or no) (no)

(organization running log)


(8) how well bottom plugged B.W.V.

DRILLERS REMARKS:

RECEIVED
MAY 8 1975

If well telescopes please sketch and show depths.

GROUND LEVEL

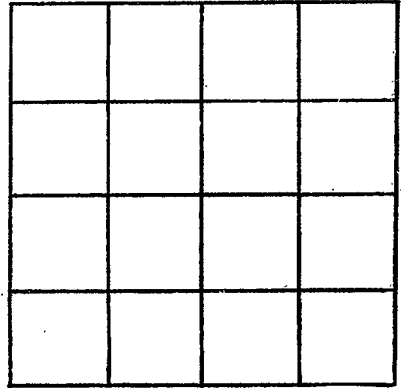

SECTION _____

Please indicate well location X.

ADDITIONAL INFORMATION

If more than one screen, show locations of each on sketch.