

Marion
 N 88
 4/75

MISSISSIPPI
 BOARD OF WATER COMMISSIONERS
 416 North State Street
 Jackson, Mississippi 39201

CODED

WATER WELL DRILLERS LOG

April 1975
 date well completed

E. B. Sheppard
 firm name

Marion
 county well located

LANDOWNER:
 James Hanberry
 Foxworth, Ms.
 (mailing address)

description of formations encountered	from	to
GRAY CHALK	0	60
50 FT. GRAY CLAY		
131' LIGHT CLAY	60	140
SMALL SAND	140	180
COARSE DEGRAD		
VERY COARSE SAND	180	213

WELL LOCATION:
 sec. 4 T 20 N R 13 E
 S W
 1/2 miles SSW Foxworth
 (distance) (direction) (nearest town)

WELL PURPOSE:
 home irrigation, municipal, industrial

- WELL COMPLETION DATA:
- (1) diameter (inches) 4 3/8"
 - (2) total depth (feet) 213'
 - (3) static water level (feet) 140' ^{below} _{above} top of ground. 140'
 - (4) casing pl. 208' (material) (depth)
 4 3/8" (size) if telescope see back.
 - (5) screen 10' (length) (depth to top)
 4" (size) pl. (material)
 - (6) pump 3/4 SUB 15 (HP) (yield gpm)
 E. (type power)
 - (7) electric log (yes or no)


(organization running log)
 (8) how well bottom plugged BWV

DRILLERS REMARKS:

RECEIVED
 APR 6 1975

If well telescopes please sketch and show depths.

GROUND LEVEL

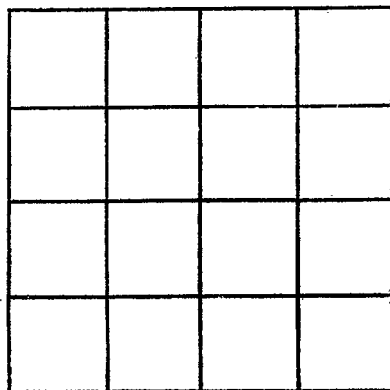

SECTION _____

Please indicate well location X.

ADDITIONAL INFORMATION

If more than one screen, show locations of each on sketch.