

Marion  
N 89  
10/74

MISSISSIPPI  
BOARD OF WATER COMMISSIONERS  
416 North State Street  
Jackson, Mississippi 39201

CODED

WATER WELL DRILLERS LOG

Oct. 1974 E.B. Sherrard Marion  
date well completed firm name county well located

LANDOWNER:	description of formations encountered	from	to
Shelton Holmes	SAND & CLAY	0	16'
Rt. 2 - Foxworth, Ms.	RED CLAY COARSE		
(mailing address)	SAND	16'	78'
	BLUE CLAY BOTTOM		

WELL LOCATION:  
sec 10 T 2 N R 13 E  
S W  
6 miles S Foxworth  
(distance) (direction) (nearest town)

WELL PURPOSE:  
(home, irrigation, municipal, industrial)


- WELL COMPLETION DATA:
- (1) diameter (inches) 4"
  - (2) total depth (feet) 78'
  - (3) static water level (feet) 30' <sup>below</sup> ~~above~~ top of ground.
  - (4) casing pl. 68' (material) (depth)  
4" (size) if telescope see back.
  - (5) screen 10' (length) (depth to top)  
4" (size) pl. (material)
  - (6) pump 1/2 (HP) 20 (yield gpm)  
E (type power)
  - (7) electric log (yes or no) (no)  
(organization running log)
  - (8) how well bottom plugged BWV

RECEIVED  
MAY - 8 1975

DRILLERS REMARKS:

If well telescopes please sketch and show depths.

GROUND LEVEL

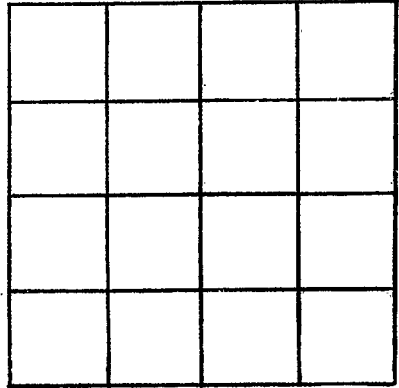

SECTION \_\_\_\_\_

Please indicate well location X.

ADDITIONAL INFORMATION

If more than one screen, show locations of each on sketch.