

Marion  
N 93  
1/75

MISSISSIPPI  
BOARD OF WATER COMMISSIONERS  
416 North State Street  
Jackson, Mississippi 39201

WATER WELL DRILLERS LOG

CODED

Jan. 1975 E. B. Sherrard Marion  
date well completed firm name county well located

LANDOWNER:	description of formations encountered	from	to
Harvey Regan	SAND & GRAVEL	0	140'
Rt. 1 - Sandy Hook (mailing address) MS.	CLAY SOFT CLAY	140'	80'
	SAND + DEA GR.	80'	118'

WELL LOCATION:  
sec 36 T 2 N R 13 E S  
9 miles S of Foxworth  
(distance) (direction) (nearest town)

WELL PURPOSE:  
(home, irrigation, municipal, industrial)


- WELL COMPLETION DATA:
- (1) diameter (inches) 2"
  - (2) total depth (feet) 118'
  - (3) static water level (feet) 40' <sup>below</sup> <sub>above</sub> top of ground.
  - (4) casing pl. 113'  
(material) (depth)  
2" (size) If telescope see back.
  - (5) screen 5'  
(length) (depth to top)  
2" (size) pl. (material)
  - (6) pump 3/4 8  
(HP) (yield gpm)  
e (type power)
  - (7) electric log (yes or no)
  - (8) how well bottom plugged BWV

DRILLERS REMARKS:

RECEIVED  
MAY 8 1975  
MISS. BU. OF WATER COMM

If well telescopes please sketch and show depths.

GROUND LEVEL

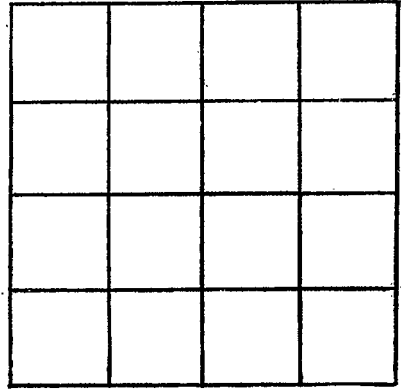

SECTION \_\_\_\_\_

Please indicate well location X.

ADDITIONAL INFORMATION

If more than one screen, show locations of each on sketch.