

Marion  
N 94  
175

MISSISSIPPI  
BOARD OF WATER COMMISSIONERS  
416 North State Street  
Jackson, Mississippi 39201

WATER WELL DRILLERS LOG


CODED

Jan. 25 1975 E.B. Sheward Marion  
date well completed firm name county well located

LANDOWNER:	description of formations encountered	from	to
Jimmy Thomas Foxworth, Ms. (mailing address)	RED CLAY SANDY CL. RED GRN SAND	0 80 80	80 111 111
<b>WELL LOCATION:</b> sec 30 T 20 N R 13 E 10 miles SW Foxworth (distance) (direction) (nearest town)			
<b>WELL PURPOSE:</b> <input checked="" type="checkbox"/> (home) Irrigation, municipal, industrial			
<b>WELL COMPLETION DATA:</b> (1) diameter (inches) 2" (2) total depth (feet) 111 (3) static water level (feet) 270 below top of ground. (4) casing pl. 107' (material) (depth) 2" if telescope see back. (size) (5) screen 5' (length) (depth to top) 2" pl. (size) (material) (6) pump 1 6 (HP) (yield gpm) E (type power) (7) electric log (yes or no) <input checked="" type="checkbox"/> (organization running log) (8) how well bottom plugged BWV			
<b>DRILLERS REMARKS:</b>	RECEIVED JAN 28 1975 MISS. BD. OF WATER COMMISSIONERS		

If well telescopes please sketch and show depths.

GROUND LEVEL

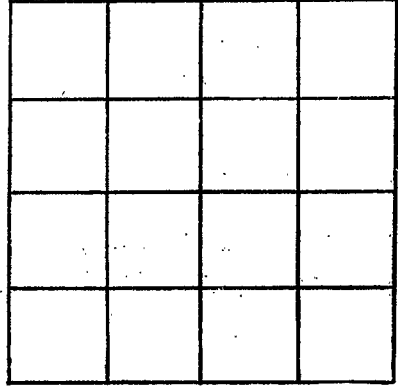

SECTION \_\_\_\_\_

Please indicate well location X.

ADDITIONAL INFORMATION

If more than one screen, show locations of each on sketch.