

Marion
N 95
7/74

MISSISSIPPI
BOARD OF WATER COMMISSIONERS
416 North State Street
Jackson, Mississippi 39201

CODED

WATER WELL DRILLERS LOG

July 1974 E.B. Sheppard Marion
date well completed firm name county well located

LANDOWNER:
Mrs Frank Rowland
Rt. 1 - Popworth Ms.
(mailing address)

description of formations encountered	from	to
SAND + GR	0	35
5 GRAY CLAY	35	75
SAND + GR	75	100
100 BLUE CLAY	100	190
SMALL GRAY + BLU		
SAND	190	245

WELL LOCATION:
sec. 9 T 20 N R 13 E
6 miles SW of Columbia
(distance) (direction) (nearest town)

WELL PURPOSE:
 home irrigation, municipal, industrial

- WELL COMPLETION DATA:
- (1) diameter (inches) 2"
 - (2) total depth (feet) 245
 - (3) static water level (feet) flow below top of ground.
 - (4) casing pl. 225 (material) (depth)
2" (size) If telescope see back.
 - (5) screen 20' (length) (depth to top)
2" (size) pl. (material)
 - (6) pump flow 25 (HP) (yield gpm)
E (type power)
 - (7) electric log (yes or no)
(organization running log)
 - (8) how well bottom plugged BNY


DRILLERS REMARKS:

RECEIVED
MAY - 8 1974

MISS. BD. OF WATER COMM

If well telescopes please sketch and show depths.

GROUND LEVEL

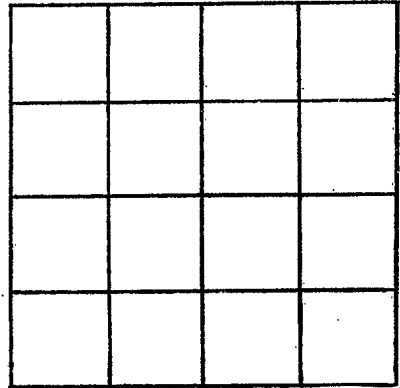

SECTION _____

Please indicate well location X.

ADDITIONAL INFORMATION

If more than one screen, show locations of each on sketch.