

Marion
N 96
7/74

MISSISSIPPI
BOARD OF WATER COMMISSIONERS
416 North State Street
Jackson, Mississippi 39201

WATER WELL DRILLERS LOG

CODED

July 1974 E. B. Sheppard Marion
date well completed firm name county well located

LANDOWNER:
Ed. Harris
Pt. 2 - Foxworth, Ms.
(mailing address)

description of formations encountered	from	to
RED SANDY CLAY	0	70
SAND + GR	70	121

WELL LOCATION:
sec. 10 T 20 N R 13 E
S
5 miles SW of Columbia
(distance) (direction) (nearest town)

WELL PURPOSE:
(home, irrigation, municipal, industrial)

- WELL COMPLETION DATA:
- (1) diameter (inches) 4"
 - (2) total depth (feet) 121
 - (3) static water level (feet) 50 ^{below} top of ground.
 - (4) casing pl. 111' (material) (depth)
4" (size) if telescope see back.
 - (5) screen 10' (length) (depth to top)
4" (size) pl. (material)
 - (6) pump 1 (HP) 20 (yield gpm)
E (type power)
 - (7) electric log (yes or no) (no)
 - (8) how well bottom plugged BWV


DRILLERS REMARKS:

REGISTERED
MAY - 8 1975

MISS. BD. OF WATER COMMISSIONERS

If well telescopes please sketch and show depths.

GROUND LEVEL

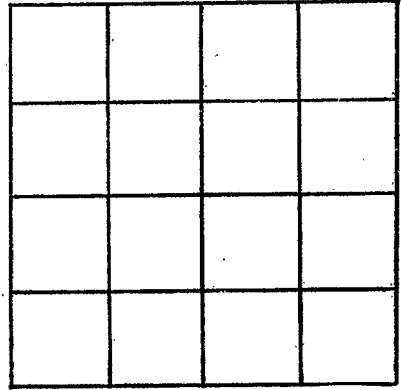

SECTION _____

Please indicate well location X.

ADDITIONAL INFORMATION

If more than one screen, show locations of each on sketch.