

Marion
N 97
7 1/4

MISSISSIPPI
BOARD OF WATER COMMISSIONERS
416 North State Street
Jackson, Mississippi 39201

CODED

WATER WELL DRILLERS LOG

July 1974 EB Sherrard Marion
 (date well completed) (firm name) (county well located)

LANDOWNER:
 (Shiloh) Church
 Rt. 1 - Kokona, Ms.
 (mailing address)

description of formations encountered	from	to
BLUE CLAY	0	30
SAND + GR	30	68'

WELL LOCATION:
 sec 2 T 2 N R 12 E
 7 miles SW of Joplin
 (distance) (direction) (nearest town)

WELL PURPOSE:
 (home) irrigation, municipal, industrial


- WELL COMPLETION DATA:
- diameter (inches) 4"
 - total depth (feet) 68'
 - static water level (feet) 8' below top of ground.
 - casing (material) pl. 58 (depth) 4" (size) if telescope see back.
 - screen 10' (length) (depth to top) 4" (size) pl. (material)
 - pump 3/4 SUB 20 (HP) (yield gpm) E (type power)
 - electric log (yes or no) (yes)
- (organization running log)
- (8) how well bottom plugged BWR

DRILLERS REMARKS:

RECEIVED
 MAY - 8 1975

If well telescopes please sketch and show depths.

GROUND LEVEL

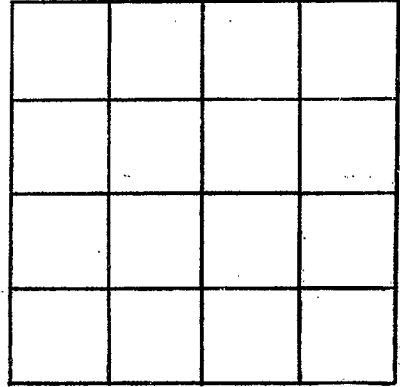

SECTION _____

Please indicate well location X.

ADDITIONAL INFORMATION

If more than one screen, show locations of each on sketch.