

MARION
N 100
10/28/78

MISSISSIPPI
BOARD OF WATER COMMISSIONERS
416 North State Street
Jackson, Mississippi 39201

CODED

WATER WELL DRILLERS LOG

10/28/78 date well completed
Griner Drilling firm name
Marion county well located

LANDOWNER:
Texaco Oil Company
1111 Rosk
Houston, Texas 77052
(mailing address)

description of formations encountered	from	to
CLAY - sand	0	80'
Sand - P. gravel	80	315'

WELL LOCATION:
sec. 15 T. 2 N R. 12 E
S W
10 miles SW of Columbia
(distance) (direction) (nearest town)

1668' N + 1500' E of
SW/Cor of Sec.

WELL PURPOSE: oil field supply
(home, irrigation, municipal, industrial)

- WELL COMPLETION DATA:
- (1) diameter (inches) 4"
 - (2) total depth (feet) 315'
 - (3) static water level (feet) 80' ^{below} top of ground.
 - (4) casing steel 260' (material) (depth)?
4" (size) if telescope see back.
 - (5) screen 42' 218' (length) (depth to top)
4" perforated (size) (material)
 - (6) pump - 80' (HP) (yield gpm)
AC (type power)
 - (7) electric log (yes or no)
(organization running log)
 - (8) how well bottom plugged orange
peel

CODED


RECEIVED
NOV - 1 1978

MISS. BD. OF WATER COMMISSIONERS

DRILLERS REMARKS:

If well telescopes please sketch and show depths.

GROUND LEVEL

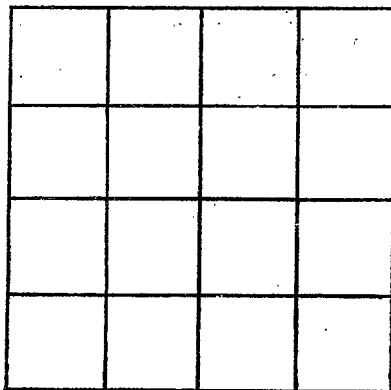

SECTION _____

Please indicate well location X.

ADDITIONAL INFORMATION

If more than one screen,
show locations of each on sketch.