

MARION  
N 101  
4/18/79  
1/1

MISSISSIPPI  
BOARD OF WATER COMMISSIONERS  
416 North State Street  
Jackson, Mississippi 39201

WATER WELL DRILLERS LOG

4-18-79 Griner Drilling Marion

date well completed firm name county well located

LANDOWNER:  
Texaco Oil Company  
Harvey, La.  
(mailing address)

description of formations encountered	from	to
chalk	0	25
sand & gravel	25	340

WELL LOCATION: 1668' N + 1500' E  
sec. 15-2 T. 2 N R. 12 W S. 1 E  
2 miles South of Kokomo  
(distance) (direction) (nearest town)

WELL PURPOSE:  
(home, irrigation, municipal, industrial)

WELL COMPLETION DATA:

- (1) diameter (inches) oil field 4 1/2"
- (2) total depth (feet) 340'
- (3) static water level (feet) 180' below top of ground
- (4) casing Steel, 340' (material) (depth)  
3 1/2" (size) if telescope see back.
- (5) screen 42' length, 298' depth to top  
3" perforated (size) (material)
- (6) pump — 80 (HP) (yield gpm)  
AC (type power)
- (7) electric log — (yes or no)  
(organization running log)
- (8) how well bottom plugged orange peel

DRILLERS REMARKS:


Miss. Board of Water Comm.

MAY 29 1979

RECEIVED

If well telescopes please sketch and show depths.

GROUND LEVEL

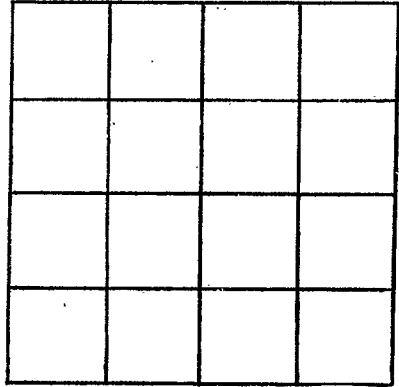

SECTION \_\_\_\_\_

Please indicate well location X.

ADDITIONAL INFORMATION

A series of horizontal lines for recording additional information.

If more than one screen, show locations of each on sketch.