

MISSISSIPPI DEPARTMENT OF NATURAL RESOURCES

Bureau of Land and Water Resources

Southport Mall

P.O. Box 10631

Jackson, Mississippi 39209

WATER WELL DRILLERS LOG

CODED

Marion
N 102
10-12-81

Griner Drilling Service, Inc.

Marion

date well completed

firm name

county well located

LANDOWNER:

ANR Production Company

14 Capitol Bldg
Suite 400

Jackson, MS address 39201

WELL LOCATION: 1700 N 4 1500 E

sec. 14 T. 20 N. R. 12 E SW/4

Wolman Knoxo Field
(distance) (direction) (nearest town)

Unit 11
PURPOSE: oil field supply
(home, irrigation, municipal)

description of formations encountered

from

to

chalk, sand, gravel

0 21

sand, gravel

21 63

chalk

63 168

sand, pea gravel

168 252

sand, gravel, chalk

252 273

chalk

273 315

WELL COMPLETION DATA:

(1) diameter (inches) 3"

(2) total depth (feet) 315'

(3) static water level (feet) 30' below above top of ground.

(4) casing steel, 273'
(material) (depth)

3"
(size) if telescope see back.

(5) screen 42', 231'
(length) (depth to top)

3", perforated
(size) (material)

(6) pump —, 100
(HP) (yield gpm)

AC
(type power)

(7) electric log —
(yes or no)

(organization running log)

(8) how well bottom plugged orange

peel

DRILLERS REMARKS:

CODED

DEPT. OF NATURAL RESOURCES
BUREAU OF LAND & WATER RESOURCES

OCT 20 1981


RECEIVED

81 OCT 30 4 8:36

RECEIVED

If well telescopes please
sketch and show depths.

GROUND LEVEL

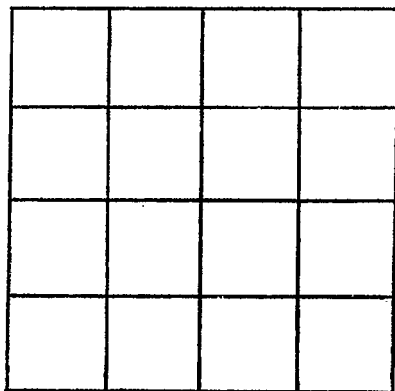

SECTION _____

Please indicate well location X.

ADDITIONAL INFORMATION

If more than one screen,
show locations of each on sketch.