

MISSISSIPPI DEPARTMENT OF NATURAL RESOURCES

Bureau of Land and Water Resources

Southport Mall

P.O. Box 10631

Jackson, Mississippi 39209

CODED

WATER WELL DRILLERS LOG

Griner Drilling Service, Inc.

Marion

MARION
N 103
12-4-81

12-4-81
date well completed

Griner Drilling Service, Inc.
firm name

Marion
county well located

| LANDOWNER: | description of formations encountered | from | to |
|--|---------------------------------------|------|-----|
| | | | |
| ANK Production 111 Capitol Building Suite 400 Jackson (mailing address) | fill + sand | 0 | 21 |
| WELL LOCATION: 1500' N + 1500' W sec. 19 T 20 N R 13 E SE/4 No. T.G. Rowell New Hope (distance) miles (direction) of (nearest town) KIRKFIELD | sand | 21 | 105 |
| WELL PURPOSE: oil field supply (home, irrigation, municipal, industrial) | sand, pea gravel | 105 | 336 |
| WELL COMPLETION DATA: | | | |
| (1) diameter (inches) 4" | | | |
| (2) total depth (feet) 336' | | | |
| (3) static water level (feet) 60' below top of ground. | | | |
| (4) casing steel, 336' (material) (depth) 4' (size) if telescope see back. | | | |
| (5) screen 42', 294' (length) (depth to top) 4" perforated (size) (material) | | | |
| (6) pump — 75 (HP) (yield gpm) AC (type power) | | | |
| (7) electric log — (yes or no) (organization running log) | | | |
| (8) how well bottom plugged orange peel | | | |
| DRILLERS REMARKS: | | | |


CODED

DEPT. OF NATURAL RESOURCES
BUREAU OF LAND & WATER RESOURCES

DEC 17 1981
RECEIVED

If well telescopes please
sketch and show depths.

GROUND LEVEL

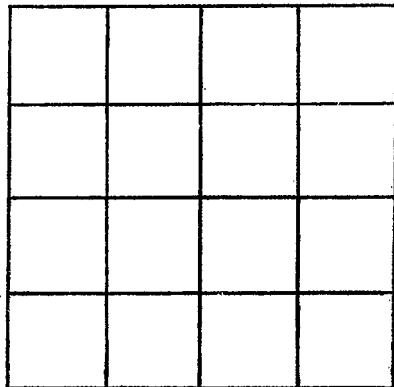

SECTION _____

Please indicate well location X.

ADDITIONAL INFORMATION

RECEIVED

81 DEC 17 A 8:46

If more than one screen,
show locations of each on sketch.