

**MISSISSIPPI DEPARTMENT OF NATURAL RESOURCES**  
 Bureau of Land and Water Resources  
 Southport Mall  
 P.O. Box 10631  
 Jackson, Mississippi 39209  
**WATER WELL DRILLERS LOG**

**CODED**

MAR 10 1986  
N 105

4-8-86 19 Tom Griffith Well Service Marion, Ms  
 date well completed firm name county well located

**LANDOWNER:** Energy Drk Co  
P.O. Box 905  
Natchez, Ms 39120  
 (mailing address)

description of formations encountered	from	to
<u>Red Sand</u>	<u>1</u>	<u>70</u>
<u>Sand + Gravel</u>	<u>70</u>	<u>300</u>

**WELL LOCATION:**  
 sec. 1 T. 1 N. R. 13 E.  
6 miles S of Columbia  
 (distance) (direction) (nearest town)

ENERGY DEVELOPMENT CORP.  
#1 MCKENZIE 1900' N E  
2310'E of SW COR.

**WELL PURPOSE:** OIL LOCATION  
 (home, irrigation, municipal, industrial)

- WELL COMPLETION DATA:**
- (1) diameter (inches) 3"
  - (2) total depth (feet) 300'
  - (3) static water level (feet) \_\_\_\_\_ below above top of ground.
  - (4) casing PVC 260'  
 (material) (depth)  
N/A if telescope see back.  
 (size)
  - (5) screen 40 260  
 (length) (depth to top)  
3" PVC  
 (size) (material)
  - (6) pump N/A 75  
 (HP) (yield gpm)  
Air lift  
 (type power)
  - (7) electric log No  
 (yes or no)  
No  
 (organization running log)
  - (8) how well bottom plugged BW V

**CODED**


**RECEIVED**  
 JUL 24 1986

Department of Natural Resources  
 Bureau of Land & Water Resources

**DRILLERS REMARKS:**

If well telescopes please sketch and show depths.

GROUND LEVEL

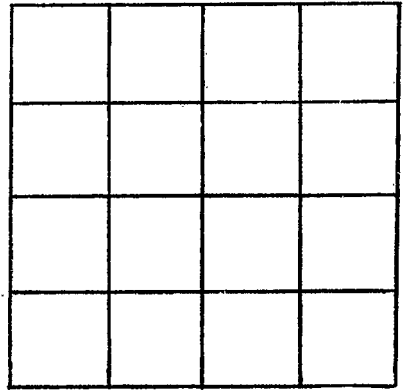

SECTION \_\_\_\_\_

Please indicate well location X.

ADDITIONAL INFORMATION

If more than one screen,  
show locations of each on sketch.