

MISSISSIPPI DEPARTMENT OF NATURAL RESOURCES

Bureau of Land and Water Resources

Southport Mall

P.O. Box 10631

Jackson, Mississippi 39209

WATER WELL DRILLERS LOG

Mayor
N 106
10-11-86

copy
Coded

10-11 1986

HOLLINGER

MARION

date well completed

firm name

county well located

LANDOWNER: <u>Shelby D White Head</u>	description of formations encountered	from	to
RT 2 <u>Foxworth</u> (mailing address)	<u>sand, gravel, Rock</u> <u>Chalk</u> <u>Fine Sand</u>	<u>0</u> <u>200</u> <u>500</u>	<u>200</u> <u>500</u> <u>588</u>
WELL LOCATION: sec <u>25</u> T <u>20</u> N S R <u>13</u> E W <u>Cheraw</u> <u>3</u> miles <u>S</u> of <u>Cheraw</u> (distance) (direction) (nearest town)			
WELL PURPOSE: <u>POND</u> (home, irrigation, municipal, industrial)			
WELL COMPLETION DATA:			
(1) diameter (inches) <u>2</u> "			
(2) total depth (feet) <u>588</u>			
(3) static water level (feet) <u>Flow</u> below above top of ground.			
(4) casing <u>pvc</u> <u>588</u> (material) (depth)			
_____ if telescope see back. (size)			
(5) screen <u>20 ft</u> <u>568</u> (length) (depth to top)			
_____ <u>pvc</u> (size) (material)			
(6) pump <u>Flow</u> <u>206 gpm</u> (HP) (yield gpm)			
_____ <u>None</u> (type power)			
(7) electric log _____ (yes or no)			
_____ (organization running log)			
(8) how well bottom plugged <u>SAND</u> <u>SHARIC</u>			
DRILLERS REMARKS: <u>Very Good</u> <u>ARTESIAN</u>			


RECEIVED

DEC 11 1987

Department of Natural Resources
Bureau of Land & Water Resources

If well telescopes please sketch and show depths.

GROUND LEVEL

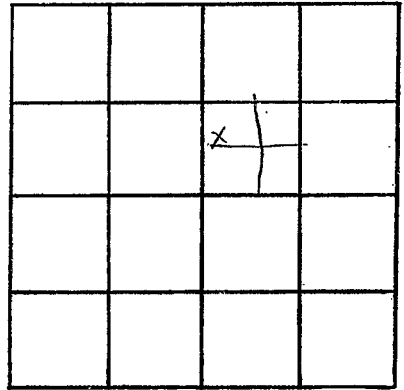

SECTION 25

Please indicate well location X.

ADDITIONAL INFORMATION

If more than one screen, show locations of each on sketch.