

Marion  
 N 2003  
 9/75

MISSISSIPPI  
 BOARD OF WATER COMMISSIONERS  
 416 North State Street  
 Jackson, Mississippi 39201

WATER WELL DRILLERS LOG

Sept. 75 E.B. Sheppard Marion  
 date well completed firm name county well located

LANDOWNER:  
 Colon Pounds  
 Foyworth, Ms.  
 (mailing address)

description of formations encountered	from	to
RED CLAY	0	10'
STREAKS SAND		
GRAVEL	10	70'
DEA GR. SAND	70	90'

WELL LOCATION:  
 sec. 9 T. 2 N. R. 13 E. 13V  
 S W  
 7 miles SW of Foyworth  
 (distance) (direction) (nearest town)

WELL PURPOSE:  
 Home irrigation, municipal, industrial


- WELL COMPLETION DATA:
- (1) diameter (inches) 2"
  - (2) total depth (feet) 90'
  - (3) static water level (feet) 35' below top of ground.
  - (4) casing pl. 85' (material) (depth)  
 2" (size) If telescope see back.
  - (5) screen 5' (length) (depth to top)  
 2" (size) pl. (material)
  - (6) pump 1 (HP) 7 (yield gpm)  
 E (type power)
  - (7) electric log  (yes or no)  
 (organization running log)
  - (8) how well bottom plugged BWW

DRILLERS REMARKS:

RECEIVED  
 DEC. - 5 1975  
 MISS. BD. OF WATER COMM.

If well telescopes please sketch and show depths.

GROUND LEVEL

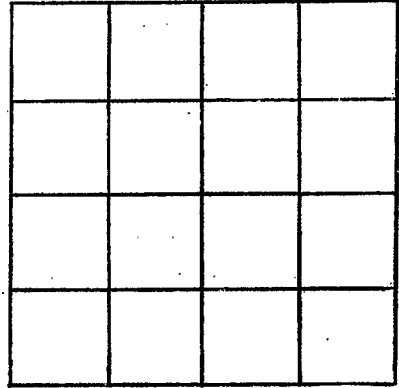

SECTION \_\_\_\_\_

Please indicate well location X.

ADDITIONAL INFORMATION

If more than one screen, show locations of each on sketch.