

Marion
 N 2004
 10/75

MISSISSIPPI
 BOARD OF WATER COMMISSIONERS
 416 North State Street
 Jackson, Mississippi 39201

WATER WELL DRILLERS LOG

Oct. 1975 E.B. Sherrard Marion
 date well completed firm name county well located


LANDOWNER:	description of formations encountered	from	to
Arlena Brown Rt. 2 - Foxworth, Ms. (mailing address)	FINE GRAY CHALK SAND & GRAVEL	0 18	8' 60'
WELL LOCATION: sec. <u>L T 20 N</u> <u>R 13 E</u> ¹³¹ <u>4</u> miles <u>S</u> of <u>Foxworth</u> (distance) (direction) (nearest town)			
WELL PURPOSE: (home, irrigation, municipal, industrial)			
WELL COMPLETION DATA:			
(1) diameter (inches) <u>2"</u>			
(2) total depth (feet) <u>60'</u>			
(3) static water level (feet) <u>18'</u> ^{below} _{above} top of ground.			
(4) casing <u>pl.</u> <u>55'</u> (material) (depth)			
<u>2"</u> (size) if telescope see back.			
(5) screen <u>5'</u> <u>pl.</u> (length) (depth to top)			
<u>2"</u> <u>pl.</u> (size) (material)			
(6) pump <u>1/3</u> <u>7</u> (HP) (yield gpm)			
<u>E</u> (type power)			
(7) electric log <u>(yes or no)</u>			
(organization running log)			
(8) how well bottom plugged <u>BWV</u>			
DRILLERS REMARKS:			

RECEIVED
 MISS. BOARD OF WATER COMMISSIONERS
 DEC - 5 1975

MISS. BD. OF WATER COMMISSIONERS

If well telescopes please sketch and show depths.

GROUND LEVEL

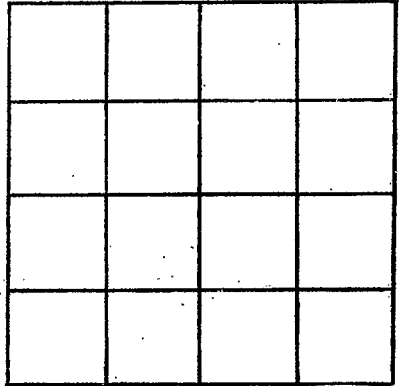

SECTION _____

Please indicate well location X.

ADDITIONAL INFORMATION

If more than one screen, show locations of each on sketch.