

Marion  
 N 2005  
 9/75

MISSISSIPPI  
 BOARD OF WATER COMMISSIONERS  
 416 North State Street  
 Jackson, Mississippi 39201

WATER WELL DRILLERS LOG

Sept. 75 E.B. Shevard Marion  
 date well completed firm name county well located

LANDOWNER:	description of formations encountered	from	to
J. Bryan Miller	GRAY CHALK	0	30'
Topworth Ms.	FINE SAND	30	50'
(mailing address)	COARSE SAND	50	76'

WELL LOCATION:  
 sec 24 T 2 N R 13 E 13V  
 7 miles S Topworth  
 (distance) (direction) (nearest town)

WELL PURPOSE:  
 (home, irrigation, municipal, industrial)


- WELL COMPLETION DATA:
- (1) diameter (inches) 2"
  - (2) total depth (feet) 76'
  - (3) static water level (feet) 32' below top of ground.
  - (4) casing pl. 71' (material) (depth)
  - 3" (size) If telescope see back.
  - (5) screen 5' (length) (depth to top)
  - 2" pl. (size) (material)
  - (6) pump 1 8 (HP) (yield gpm)
  - E (type power)
  - (7) electric log (yes or no) (no)
  - (organization running log)
  - (8) how well bottom plugged BWV

DRILLERS REMARKS:

REGISTERED  
 DEC - 5 1975  
 MISS. BD. OF WATER COMMISSIONERS

If well telescopes please sketch and show depths.

GROUND LEVEL

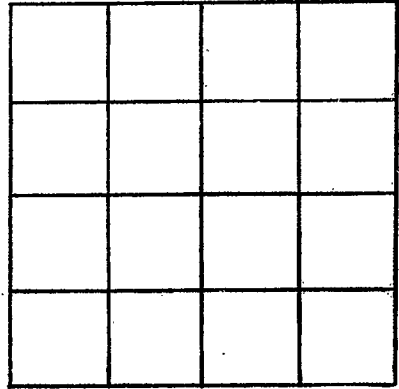

SECTION \_\_\_\_\_

Please indicate well location X.

ADDITIONAL INFORMATION

If more than one screen, show locations of each on sketch.