

Marion
 N 2006
 10/75

MISSISSIPPI
 BOARD OF WATER COMMISSIONERS
 416 North State Street
 Jackson, Mississippi 39201

WATER WELL DRILLERS LOG

Oct. 25 E.B. Sheppard Marion
 date well completed firm name county well located

LANDOWNER:
 James Miller
 Foyworth, Ms.
 (mailing address)

description of formations encountered	from	to
GRAY CLAY	0	20'
GRAVEL + SAND	20	60'

WELL LOCATION:
 sec 24 T 20 N R 13 E 13V
 S W
 8 miles SE Foyworth
 (distance) (direction) (nearest town)

WELL PURPOSE:
 home irrigation, municipal, industrial


- WELL COMPLETION DATA:
- (1) diameter (inches) 2"
 - (2) total depth (feet) 60'
 - (3) static water level (feet) 20' ^{below}/_{above} top of ground.
 - (4) casing pl. 55'
 (material) (depth)
 2" If telescope see back.
 (size)
 - (5) screen 5' pl.
 (length) (depth to top)
 2" pl.
 (size) (material)
 - (6) pump 1/2 7
 (HP) (yield gpm)
E
 (type power)
 - (7) electric log (yes or no)
 (organization running log)
 - (8) how well bottom plugged BWV

DRILLERS REMARKS:

RECEIVED
 MISS. DD. OF WATER COMM
 DEC - 5 1975

If well telescopes please sketch and show depths.

GROUND LEVEL

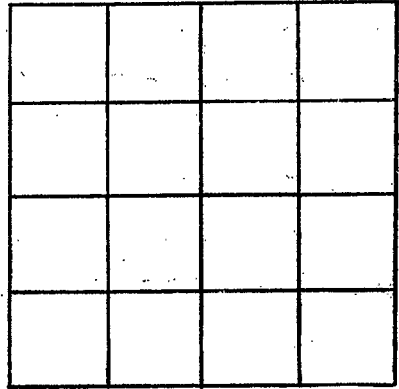

SECTION _____

Please indicate well location X.

ADDITIONAL INFORMATION

If more than one screen,
show locations of each on sketch.