

Marion  
 N 2007  
 11/75

MISSISSIPPI  
 BOARD OF WATER COMMISSIONERS  
 416 North State Street  
 Jackson, Mississippi 39201

WATER WELL DRILLERS LOG

Nov. 1975 E.B. Sherrard Marion  
 date well completed firm name county well located


LANDOWNER:	description of formations encountered	from	to
Lannie Stringer Forworth, Ms. (mailing address)	RED CLAY SANDY RED CLAY DEEP BR SAND	0	140' 80' 120'
<b>WELL LOCATION:</b> sec. 5 T 2 N R 13 E 131 4 1/4 miles SW Forworth (distance) (direction) (nearest town)			
<b>WELL PURPOSE:</b> <input checked="" type="checkbox"/> home <input type="checkbox"/> irrigation, municipal, industrial			
<b>WELL COMPLETION DATA:</b>			
(1) diameter (inches) 2"			
(2) total depth (feet) 120'			
(3) static water level (feet) 72' below top of ground.			
(4) casing (material) pl. (depth) 115'			
2" (size) if telescope see back.			
(5) screen 5' (length) (depth to top)			
2" (size) pl. (material)			
(6) pump 1 (HP) 7 (yield gpm)			
E (type power)			
(7) electric log <input checked="" type="checkbox"/> (yes or no)			
(organization running log)			
(8) how well bottom plugged BWV			
<b>DRILLERS REMARKS:</b>			

RECEIVED  
 DEPT. OF WATER COMMISSIONERS  
 DEC - 5 1975

MISS. BD. OF WATER COMMISSIONERS

If well telescopes please sketch and show depths.

GROUND LEVEL

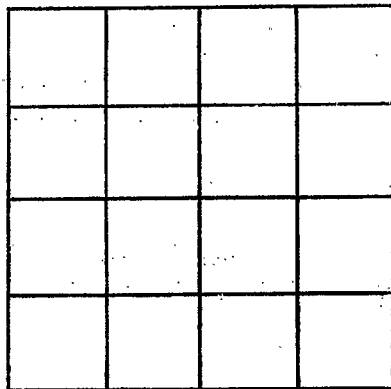

SECTION \_\_\_\_\_

Please indicate well location X.

ADDITIONAL INFORMATION

If more than one screen, show locations of each on sketch.