

Marion
 N 2008
 12/75

MISSISSIPPI
 BOARD OF WATER COMMISSIONERS
 416 North State Street
 Jackson, Mississippi 39201

WATER WELL DRILLERS LOG

December 25 1975 E. B. Sherrard Marion
 date well completed firm name county well located

LANDOWNER:
 Clayton Pittman
 Foxworth, Ms.
 (mailing address)

description of formations encountered	from	to
LOOSE RED		
SANDY CLAY	0	75
SAND	75	100
SAND & GRAVEL	100	119

WELL LOCATION:
 sec 16 T 2 N R 13 E 13V
 6 miles S of Foxworth
 (distance) (direction) (nearest town)

WELL PURPOSE:
 (home) irrigation, municipal, industrial

- WELL COMPLETION DATA:
- (1) diameter (inches) 2"
 - (2) total depth (feet) 119'
 - (3) static water level (feet) 65' ^{below} _{above} top of ground.
 - (4) casing pl. 114'
 (material) (depth)
 2' if telescope see back.
 (size)
 - (5) screen 5' pl.
 (length) (depth to top)
 2" pl.
 (size) (material)
 - (6) pump 1 7
 (HP) (yield gpm)
0
 (type power)
 - (7) electric log (yes or no)
 - (organization running log)
 - (8) how well bottom plugged BWV


RECEIVED
 DEC - 5 1975

MISS. BD. OF WATER COMMISSIONERS

DRILLERS REMARKS:

If well telescopes please sketch and show depths.

GROUND LEVEL

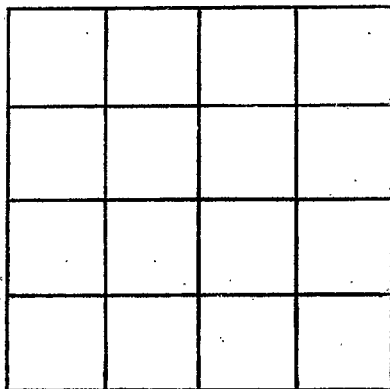

SECTION _____

Please indicate well location X.

ADDITIONAL INFORMATION

If more than one screen, show locations of each on sketch.