

Marion
N 2010
Jan. 1976

MISSISSIPPI
BOARD OF WATER COMMISSIONERS
416 North State Street
Jackson, Mississippi 39201

WATER WELL DRILLERS LOG

~~Marion~~ 1976 E.B. SHERBARD MARION
date well completed firm name county well located

LANDOWNER:

IRVIN PITTMAN
FOXWORTH, MISS
(mailing address)

description of formations encountered

from to

SANDY SANDY
LOOSE REDDISH
GRAVEL & COARSE
SAND & PEA GR. 0 60'
60 80'

WELL LOCATION:

sec. 8 T2N R13E
6 miles SW FOXWORTH
(distance) (direction) (nearest town)

WELL PURPOSE:

(home, irrigation, municipal, industrial)

WELL COMPLETION DATA:

- (1) diameter (inches) 2"
- (2) total depth (feet) 80'
- (3) static water level (feet) 40' below above top of ground.
- (4) casing apl. 75' (material) (depth)
2" (size) if telescope see back.
- (5) screen 5' (length) (depth to top)
2" (size) (material)
- (6) pump 1 (HP) 7 (yield gpm)
E (type power)
- (7) electric log (yes or no) (no)
(organization running log)
- (8) how well bottom plugged BWV

DRILLERS REMARKS:


RECEIVED

OCT 18 1976

MISSISSIPPI BOARD OF WATER COMMISSIONERS

If well telescopes please sketch and show depths.

GROUND LEVEL

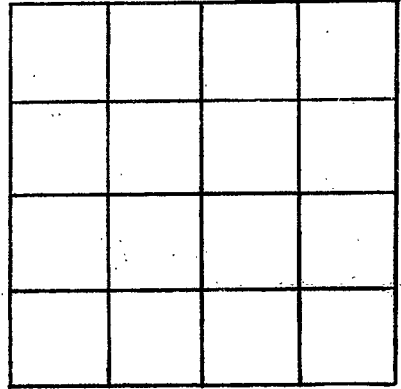

SECTION _____

Please indicate well location X.

ADDITIONAL INFORMATION

If more than one screen,
show locations of each on sketch.