

MARION  
 N 2011  
 1-19-76

MISSISSIPPI  
 BOARD OF WATER COMMISSIONERS  
 416 North State Street  
 Jackson, Mississippi 39201

WATER WELL DRILLERS LOG

Jan. 19 1976 *Stafford Water Well Dr.* Marion  
 date well completed firm name county well located

LANDOWNER: <i>Jeffie Stogard</i>	description of formations encountered	from	to
<i>Pt. 2</i>	<i>top soil</i>	<i>0</i>	<i>2</i>
<i>Sandy Hook, Miss</i> (mailing address)	<i>clay</i>	<i>2</i>	<i>40</i>
WELL LOCATION: sec. <i>3</i> T. <i>1</i> N. R. <i>13</i> E	<i>clay gravel</i>	<i>40</i>	<i>60</i>
<i>7 1/2</i> miles <i>NW</i> of <i>Sandy Hook</i>	<i>fine sand</i>	<i>60</i>	<i>85</i>
(distance) (direction) (nearest town)	<i>course sand</i>	<i>85</i>	<i>108</i>

WELL PURPOSE: *Home*  
 (home, irrigation, municipal, industrial)

- WELL COMPLETION DATA:
- (1) diameter (inches) 4"
  - (2) total depth (feet) 108 ft.
  - (3) static water level (feet) \_\_\_\_\_ below  
 top of ground. above
  - (4) casing plastic, 98 ft.  
 (material) (depth)
  - 4  
 (size) If telescope see back.
  - (5) screen 10 ft., 98  
 (length) (depth to top)
  - 4", plastic  
 (size) (material)
  - (6) pump \_\_\_\_\_ (HP) \_\_\_\_\_ (yield gpm)
  - \_\_\_\_\_ (type power)
  - (7) electric log \_\_\_\_\_ (yes or no)
  - \_\_\_\_\_ (organization running log)
  - (8) how well bottom plugged BWV


RECEIVED  
 FEB 6 - 1976

DRILLERS REMARKS:  
*Salmae Dyer*

MISS. Bd. OF WATER COMM.

If well telescopes please sketch and show depths.

GROUND LEVEL

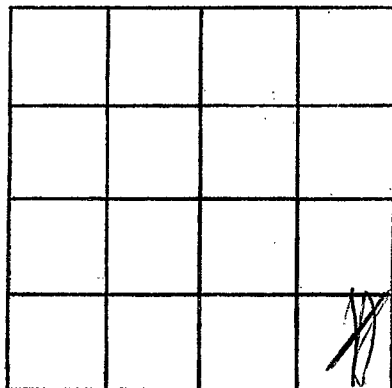

SECTION \_\_\_\_\_

Please indicate well location X.

ADDITIONAL INFORMATION

If more than one screen,  
show locations of each on sketch.