

Marion
 N 2012
 3/76

MISSISSIPPI
 BOARD OF WATER COMMISSIONERS
 416 North State Street
 Jackson, Mississippi 39201

WATER WELL DRILLERS LOG

March 1976 E.P. Sheppard Marion
 date well completed firm name county well located

LANDOWNER:
 D. Miller, Jr.
 Forworth, Ms.
 (mailing address)

description of formations encountered	from	to
CLAY - GRAYISH	0	30'
SAND & PEA CK.	30	80'

WELL LOCATION:
 sec 24 T 2 N R 18 E
 S of Forworth
 8 miles (distance) (direction) (nearest town)

WELL PURPOSE:
 (home) irrigation, municipal, industrial


- WELL COMPLETION DATA:
- (1) diameter (inches) 2"
 - (2) total depth (feet) 80'
 - (3) static water level (feet) 32' below top of ground.
 - (4) casing (material) pl. (depth) 75'
 - 2" (size) if telescope see back.
 - (5) screen 5' (length) (depth to top)
 - 2" (size) pl. (material)
 - (6) pump 1 (HP) 8 (yield gpm)
 - elec. (type power)
 - (7) electric log (yes or no)
 - (organization running log)
 - (8) how well bottom plugged BWV

DRILLERS REMARKS:

RECEIVED
 OCT 18 1976

If well telescopes please sketch and show depths.

GROUND LEVEL

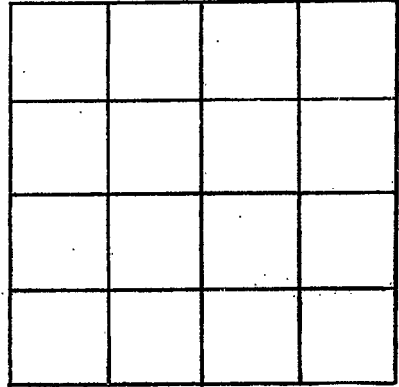

SECTION _____

Please indicate well location X.

ADDITIONAL INFORMATION

If more than one screen, show locations of each on sketch.